


RICE


KANSAS

Section 17 Township 21 Range 7W

Well Number 1 Johnson

Company Westgate-Greenland Oil Co.

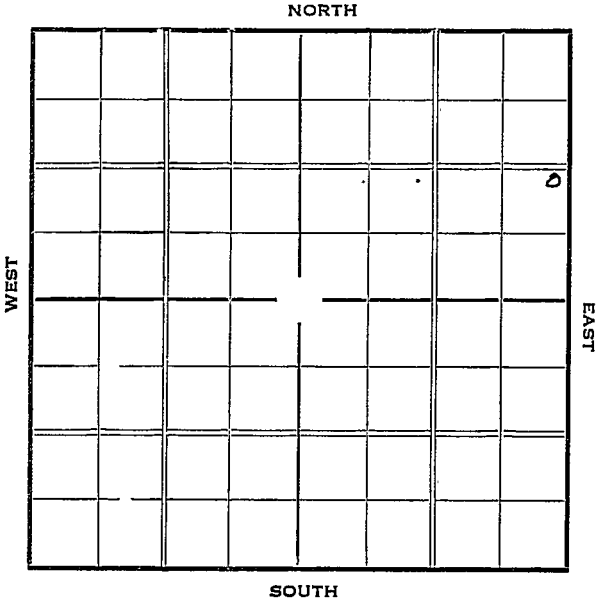

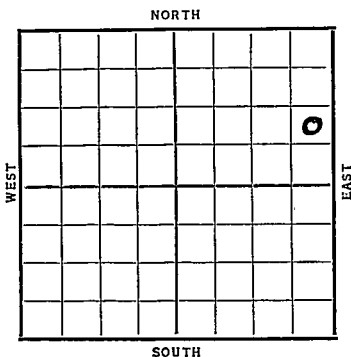Sec. 17 Twp. 21 R. 7-WWell No. #1 Johnson FarmWestgate-Greenland Oil Company Ft. from N. Line990 Ft. from S. Line330 Ft. from E. Line Ft. from W. LineElev. 1618.Date
1937

REPORT

1/13Location1/28"2/4"2/11Rigging up2/1812" @ 115'. Drlg. 1650'.2/26Drlg. 3125'.3/4Conglomerate 3366'.Set 7" RUST3/11T.D. 3385'. No test.3/17Conglomerate 3366'.T. D. 3385'.Potential 1899.**COMPLETED**

KANSAS

Map No. 49 Sec. 17 Twp. 21 R. 7WWell No. JohnsonHestgate - Greenland Oil Company

Contractor

SECTION PLAT

			0

 Ft. from N. Line990 Ft. from S. Line230 Ft. from E. Line Ft. from W. Line

FIRST REPORT

Location ✓Rig up

Drilling and Remarks:

RECORD

Cased in., ft.Sand Gas Oil Total Depth

PRODUCTION

1st 24 hrs. Nat. 1st 24 hrs. after shot Gas Cu. Ft.Dry Hole Abandoned

Date

JAN 13 1937

19

S. J. LEWIS

Scout

KANSAS *Rice*Map No. 47 Sec. 17 Twp. 21 R. 7WWell No. JohnsonWestgate - Greenland Oil Company

Contractor

SECTION PLAT

			◊

_____ Ft. from N. Line

990 Ft. from S. Line330 Ft. from E. Line

_____ Ft. from W. Line

COMPLETED

Location _____

Rig up _____

Drilling and Remarks:

Conglomerate
3366
Potential
1899

RECORD

Cased _____ in., _____ ft.

Sand _____

Gas _____

Oil _____

Total Depth 3385

PRODUCTION

1st 24 hrs. Nat. _____

1st 24 hrs. after shot _____

Gas _____ Cu. Ft.

Dry Hole _____

Abandoned _____

Date

MAR 17 1937 19

S. J. LEWIS Scout