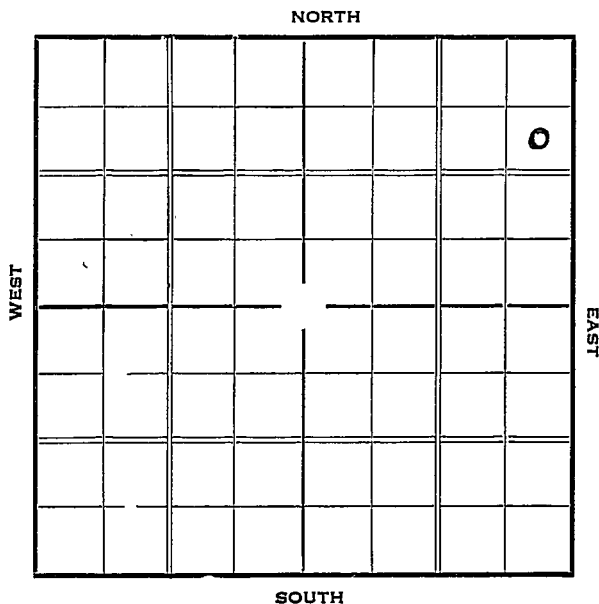


Section 17 Township 21 Range 7-WWell Number 3 JohnsonCompany Alyword Prod.

Map No. _____ Sec. 17 Twp. 21 R. 7WWell No. 3 JohnsonEdward Pool Company

Contractor

SECTION PLAT

			o

990 Ft. from N. Line

_____ Ft. from S. Line

830 Ft. from E. Line

_____ Ft. from W. Line

FIRST REPORT

Location _____

Rig up _____

Drilling and Remarks:

Rig

o

RECORD

Cased _____ in., _____ ft.

Sand _____

Gas _____

Oil _____

Total Depth _____

PRODUCTION

1st 24 hrs. Nat. _____

1st 24 hrs. after shot _____

Gas _____ Cu. Ft.

Dry Hole _____

Abandoned _____

Date

FEB 10 1937 ₁₉

S. J. LEWIS Scout

KANSAS *Pic*Map No. _____ Sec. *17* Twp. *21* R. *7W*Well No. *3 Johnson**Rayward Pool* Company

Contractor

SECTION PLAT

			<i>0</i>

990 Ft. from N. Line

_____ Ft. from S. Line

330 Ft. from E. Line

_____ Ft. from W. Line

COMPLETED

Location _____

Rig up _____

Drilling and Remarks:

*Conglomerate**3379**P.B. 3389**70 Shot Lane well**gun.**Potential**1015.*

RECORD

Cased _____ in., _____ ft.

Sand _____

Gas _____

Oil _____

Total Depth *3399*

PRODUCTION

1st 24 hrs. Nat. _____

1st 24 hrs. after shot _____

Gas _____ Cu. Ft.

Dry Hole _____

Abandoned _____

Date

APR 14 1937 19

S. J. LEWIS Scout