

Rice


KANSAS

SECTION 17 TOWNSHIP 21 RANGE 8 W

WELL NO. #1 Altland

COMPANY Jones, Shelburne & Farmer

NORTH

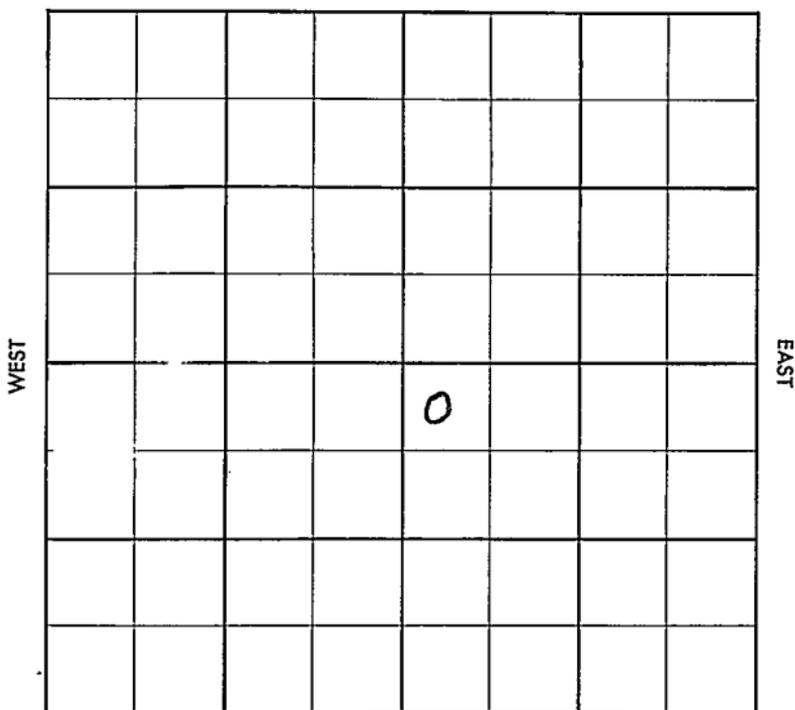

SOUTH

Rice

KANSAS

SEC.	TWP.	R.
17	21	8W

WELL NO.

#1 Altland

FARM

COMPANY

Jones, Shelburne & Farmer

CONTRACTOR

Mast Drlg


Wildcat

_____ Ft. from N. Line

_____ Ft. from S. Line

_____ Ft. from E. Line

_____ Ft. from W. Line

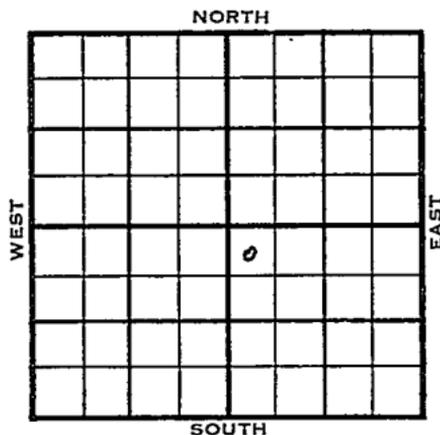

NW N W SE

	ELEVATION	REPORT
1955	1649	

11/16 Loc

12-7

Comm. 11-22-55

8 5/8" @ 210/175

DST 3258-67 op 1 hr. rec. 60' gas 20'
mud, 90/20"

D & A

BL. 2901

L. 2942

Cherty 3258

K. 3289

K. 3289

Sd. 3486

V. 3550

Sd. 3576


A. 3641

TD 3649'

ABANDONED

County Ryce Elev. _____
 Sec. 17 Twp. 21 Rge. 8W
 Company Jones, Shelburne & Farmer
 Farm Name Attland No. 1

TOPS	DEPTH	LOG	DATUM	Loc. in Sec.
Anh.				NW NW SE
Tp.				
H.				
Tr.				
Dg.				
Bl.				
L.				
K.C.				Geol. _____
B.K.C.				Contr. _____
Ce.				
C.				<u>Must Drlg.</u>
M.				
M.				Pool _____
K.				<u>Wildcat</u>
Mz.				
Me.				
V.				
S.				
S.				
A				
R.				
PE				
G.				
T.D.				

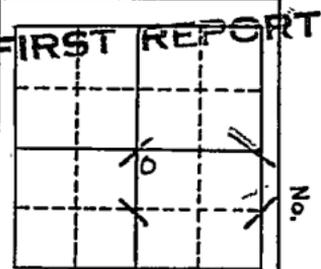

Date Comm. NOV 16 1955
 Location _____

[Handwritten signature]

Co.
Lse.
No.
Sec.
T.
R.

County Rice Elev. 1649
 Sec. 17 Twp. 21 Rge. 8W
 Company Jones, Shelburne & Farmer
 Farm Name Altland No. 1

TOPS	DEPTH	LOG	DATUM
Anh.			
Tr.			
H.			
Dg.			
Bl.	<u>2901</u>		<u>1252</u>
L.	<u>2942</u>		<u>1293</u>
K.C.			
B.K.C.			
Ce.			
C. <u>Cherty</u>	<u>3258</u>		<u>1609</u>
M.			
M.			
K.	<u>.3289</u>		<u>1640</u>
Mz. <u>sd</u>	<u>.3486</u>		<u>1837</u>
Mq.			
V.	<u>.3550</u>		<u>1901</u>
S. <u>sk</u>	<u>.3576</u>		<u>1927</u>
S.			
A.	<u>.3641</u>		<u>1992</u>
R.			
PE.			
G.			
TD.	<u>.3649</u>		

Loc. in Sec. NW NW SE
 Geol. _____
 Contr. _____
 Pool _____
Mast Drlg.
Wildcat



Date Comm. 11-22-55 DEC 7 1955
8 5/8" @ 210/175 DST 3258-67 open 1 hr.
rec. 60' gas 20' mud 90/20"

D & A

Co.
 Lse.
 No.
 Sec.
 T.
 R.