


Section 17 Township 21 Range 11W

Well No. 3 Smith "A"

Company Champlin Oil Ref.

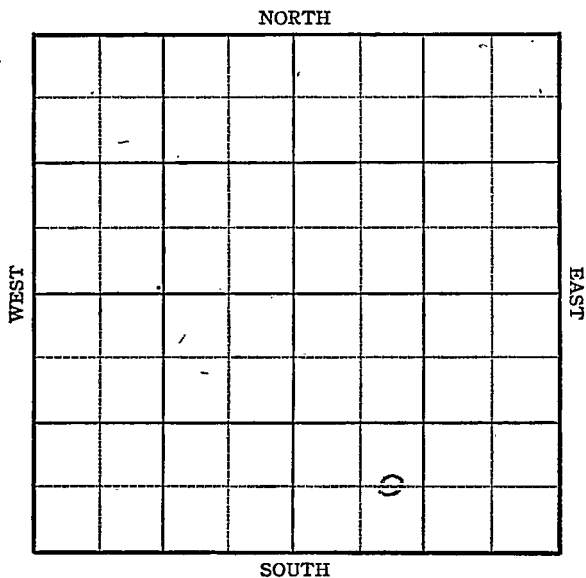

Sec. 17 Twp. 21 R. 11-W

Well No. #3 Smith "A" Farm


Champlin Oil Ref. Company

_____ Ft. from N. Line

660 Ft. from S. Line

_____ Ft. from E. Line

990 Ft. from W. Line

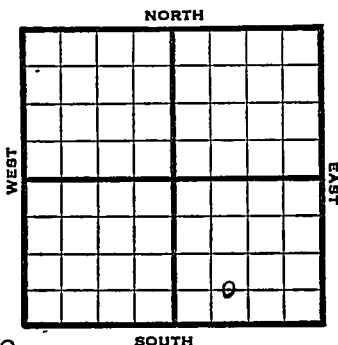

C E L SW SE Elev. 1770

1945

REPORT

9/12	Location
9/19	8" @ 330 Drlg. 2030
9/26	Drlg. 3365
10/3	Lans. 3115 Cong 3355 Simp Sh 3360 Simp Sd 3368 Arb. 3415 TD 3418
10/10	5" @ 3415 RUST 12500 acid. 1600' oil 5 hrs. TD 3422 swb. 7 oil per hr.
10/17	Swb. 7 oil per hr. 7 hrs.
10/24	" " " " "
10/31	" " " " "
11/7	" " " " "
11/14	" " " " "
11/21	Arb. 3415 5" @ 3415 1250 acid. TD 3422 Pump 147 Pot. Grav. 46.0

COMPLETED

KANSAS
KANSASPool Name SniderMap No. 46 Sec. 17 Twp. 21 R. 11WWell No. 3 Smith "A"Champlin Oil Ref. Company

FIRST REPORT

Contractor

C E L SW SE

SECTION PLAT

 Ft. from N. Line660 Ft. from S. Line Ft. from E. Line990 Ft. from W. Line

Stafford County

Location XRig up

Drilling and Remarks:

RECORD

Cased in., ft.Sand Gas Oil Total Depth

PRODUCTION

1st 24 hrs. Nat. 1st 24 hrs. after shot Gas Cu. Ft.Dry Hole Abandoned

Date

SEP 12 1945 19S. J. LEWIS Scout

KANSAS Pool Name Snider
 Kansas
 Map No. 46 Sec. 17 Twp. 21 R. 11W
 Well No. 3 Smith A

Champlin Oil Ref. _____ Company _____

COMPLETED

Contractor

C E L SW SE

E 11 1970

SECTION PLAT

_____ Ft. from N. Line

660 Ft. from S. Line

_____ Ft. from E. Line

990 Ft. from W. Line

Stafford County

Location _____

Rig up _____

Drilling and Remarks:

Cor 3415

5" C 3415

1250 acid

Pump 147 P.D.

462 Gr

RECORD

Cased _____ in., _____ ft.

Sand _____

Gas _____

Oil _____

Total Depth 3422

PRODUCTION

1st 24 hrs. Nat. _____

1st 24 hrs. after shot _____

Gas _____ Cu. Ft.

Dry Hole _____

Abandoned _____

Date _____

NOV 21 1945 19

S. J. LEWIS Scout