

Sec. 17 - Twp. 21 R. 11-W

Well No. ~~#2~~ Smith #1-"B" Farm

Champlin Company


(Snider)

660 Ft. from N. Line

_____ Ft. from S. Line

330 Ft. from E. Line

_____ Ft. from W. Line

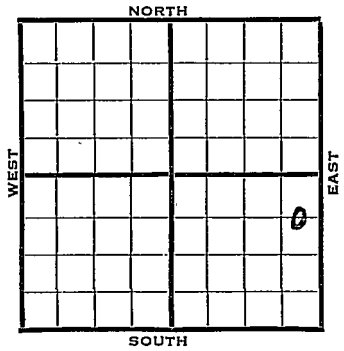

Elev. 1768

1940	REPORT
6/12	Anhy. 516' 10" - 282' Drlg. 1903'
6/20	Simp. sand 3335½' T.D. 3338' 5½" - 3336' RUST.
6/27	Topeka 2700' Lansing 3120' B.K.C. 3350' Cong. 3360' Simp. 3367' Core 3368-80' SSO Core 3380-89½' T.D. S.O. 5½" - 3367' RUST.
7/3	T.D. 3390' 2500' oil 1/4 hour.
7/10	Simp. sand 3367' 5" - 3367' T.D. 3390' Potential 565 bbls., flow.
COMPLETED	

Map No. 46 Sec. 17 Twp. 21 R. 11WWell No. 2 SmithChamplin Company

Contractor

FIRST REPORT660 **C E L N E S E**
Ft. from N. Line

Ft. from S. Line

330 Ft. from E. Line

Ft. from W. Line

SNIDER POOL**SECTION PLAT**

			o

Location _____

Rig up _____

Drilling and Remarks:

Anhy 516
10" - 282

Drlg. 1903

RECORD

Cased _____ in., _____ ft.

Sand _____

Gas _____

Oil _____

Total Depth _____

PRODUCTION

1st 24 hrs. Nat. _____

1st.24 hrs. after shot _____

Gas _____ Cu. Ft.

Dry Hole _____

Abandoned _____

Date

JUN 12 1940

19

S. J. LEWIS Scout

Map No. _____ Sec. 17 Twp. 21 R. 11WWell No. 1 Smith "B"_____ Champlin Refining _____ CompanyCORRECTION _____ Contractor**SECTION PLAT**

			□

C E L N E S E

660 Ft. from N. Line

_____ Ft. from S. Line

330 Ft. from E. Line

_____ Ft. from W. Line

SNIDER POOL

Location _____

Rig up _____

Drilling and Remarks:

Reported as
#2 Smith**RECORD**

Cased _____ in., _____ ft.

Sand _____

Gas _____

Oil _____

Total Depth _____

PRODUCTION

1st 24 hrs. Nat. _____

1st 24 hrs. after shot _____

Gas _____ Cu. Ft.

Dry Hole _____

Abandoned _____

Date

JUL 10 1940
19

S. J. LEWIS Scout

Map No. _____ Sec. 17 Twp. 21 R. 11W

Well No. 1 Smith "B"

Champlin Refining Company

Contractor

COMPLETED

C E L N E S E

660 Ft. from N. Line

_____ Ft. from S. Line

330 Ft. from E. Line

_____ Ft. from W. Line

SNIDER POOL

SECTION PLAT

			o

Location _____

Rig up _____

Drilling and Remarks:

*Shut Sol 3367**5" c 3367**Flow 565 28.***RECORD**

Cased _____ in., _____ ft.

Sand _____

Gas _____

Oil _____

Total Depth *3390***PRODUCTION**

1st 24 hrs. Nat. _____

1st 24 hrs. after shot _____

Gas _____ Cu. Ft.

Dry Hole _____

Abandoned _____

Date

JUL 10 1946 19

S. J. LEWIS Scout