

KANSAS

Form 51-5M-7-40-Palace

Stafford

Section 17 Township 21 Range 11-W

Well No. #4 Smith "B"


Company Champlin Refining

NORTH

Snider Pool

WEST

EAST

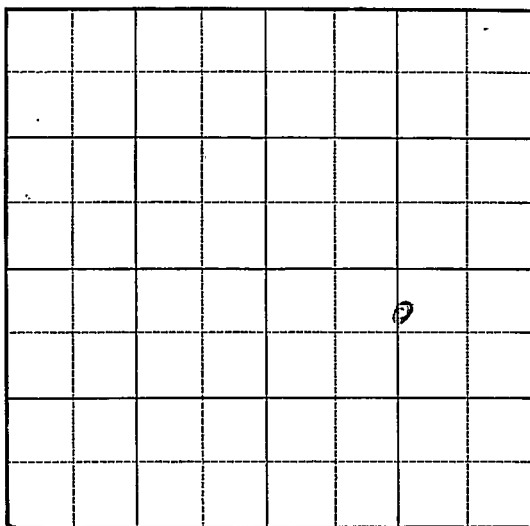

SOUTH

Map No. 46 Sec. 17 Twp. 21 R. 11WWell No. 4 Smith "B"Champlin Refining Company

Contractor


FIRST REPORT**SECTION PLAT**400 C N L SE
Ft. from N. Line

Ft. from S. Line

1240 Ft. from E. Line

Ft. from W. Line

SNIDER POOL

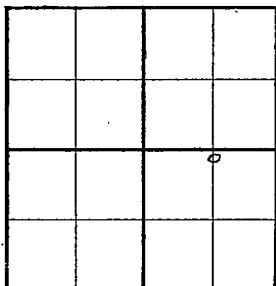

Location _____

Rig up _____

Drilling and Remarks:

10" - 360Simpson Sd. 3374T.D: 33965" 33742500' oil in 5 1/2 hrscore 3377-89; 10' Recovery Cu. Ft.Gd. Sat. Core 3389-92 Dry HoleRecy. 5' Gd. Sat. 3395 AbandonedSwb. 26 bbl. Per Hr. C.O.**RECORD**

Cased _____ in., _____ ft.

Sand _____

Gas _____

Oil _____

Total Depth _____

PRODUCTION

1st 24 hrs. Nat. _____

1st 24 hrs. after shot _____

Recovery _____ Cu. Ft.

Dry Hole _____

Abandoned _____

Date

OCT 9 1926 19 S. J. LEWIS Scout

Map No. 46 Sec. 17 Twp. 21 R. 11WWell No. 4 Smith "B"Champlin Refining Company

Contractor

COMPLETED**SECTION PLAT**400 C N L SE
Ft. from N. Line

Ft. from S. Line

1240 Ft. from E. Line

Ft. from W. Line

SNIDER POOL

Location

Rig up

Drilling and Remarks:

*Drill to 13874**3" C 3374**Bore + P 8 1942***RECORD**

Cased _____ in., _____ ft.

Sand _____

Gas _____

Oil _____

Total Depth 3395**PRODUCTION**

1st 24 hrs. Nat. _____

1st 24 hrs. after shot _____

Gas _____ Cu. Ft.

Dry Hole _____

Abandoned _____

Date

OCT 23 1940 19S. J LEWIS Scout