


Section 18 Township 21 Range 12-W

Well No. #1 Christenson (Christianson)

Company Honoker Drlg.

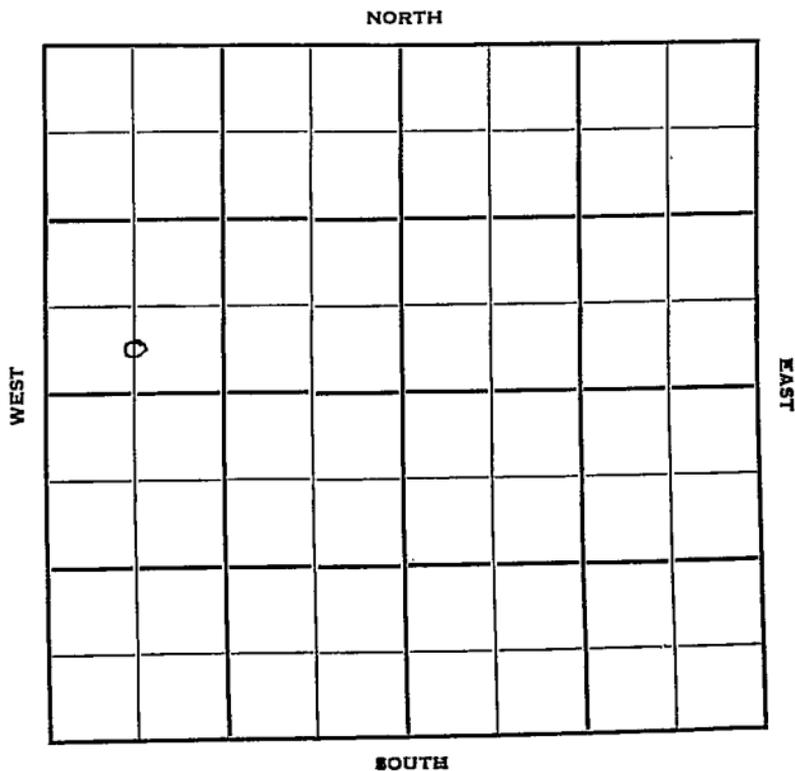

Sec. 18 Twp. 21 R. 12W

Well No. #1 Christenson Farm

Honoker Drlg. Company

Contractor

Ft. from N. Line

330'


Ft. from S. Line

Ft. from E. Line

660'

Ft. from W. Line

C S/2 SW NW

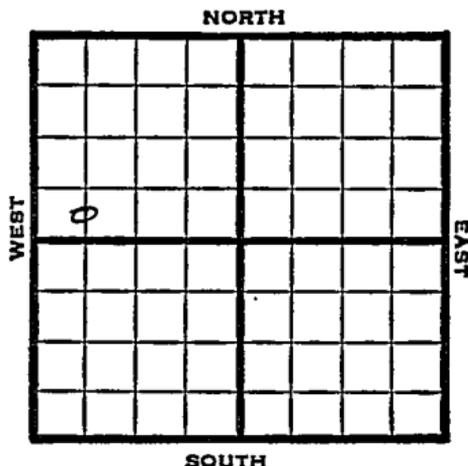

1950

Elev 1863'

REPORT

5/24

8" @ 340'
Drlg. 2460'

5/31

8" @ 340
Lans 3272
Cong 3515
Viola 3538
Simp 3544
TD 3590
D&A

ABANDONED

Kansas

Map No. _____ Sec. 18 Twp. 21 R. 12W

Well No. 1 Christenson

Honoker Drlg. _____ Company

C S/2 SW NW _____ Contractor

SECTION PLAT

_____ Ft. from N. Line

330 _____ Ft. from S. Line

_____ Ft. from E. Line

660 _____ Ft. from W. Line

FIRST REPORT			
o			

Stafford

Location _____

Rig up _____

Drilling and Remarks: ..

8" u @ 340

Drlg. 2460

RECORD

Cased _____ in., _____ ft.

Sand _____

Gas _____

Oil _____

Total Depth _____

PRODUCTION

1st 24 hrs. Nat. _____

1st 24 hrs. after shot _____

Gas _____ Cu. Ft.

Dry Hole _____

Abandoned _____

Date

MAY 24 1919

J. E. TYRA Scout

Map No. _____ Sec. 18 Twp. 21 R. 12W

Well No. 1 Christenson

Honoker Drlg. _____ Company

_____ Contractor

C S/2 SW NW

E-1. 1863
SECTION PLAT

_____ Ft. from N. Line

330 Ft. from S. Line

_____ Ft. from E. Line

660 Ft. from W. Line

0			
ABANDONED			

Stafford

Location _____

Rig up _____

Drilling and Remarks:

8" C 340
Lane. 3272
Comp. 3515
Vide 3538
Simp. 3544
T.D. 3590
D+A

RECORD

Cased _____ in., _____ ft.

Sand _____

Gas _____

Oil _____

Total Depth 3590

PRODUCTION

1st 24 hrs. Nat. _____

1st 24 hrs. after shot _____

Gas _____ Cu. Ft.

Dry Hole _____

Abandoned _____

Date

MAY 31 1950 19 _____

J. E. TYRA _____ Scout