

KANSAS

O.W.W.O.


Stafford

FORM. 51 5M PETROL

Section 18 Township 21 Range 12-W
~~21-W~~

Well No. #1 Welsh "A"

Company ~~W. P. Toulkner et al~~ **R-M-SIEGRIED**

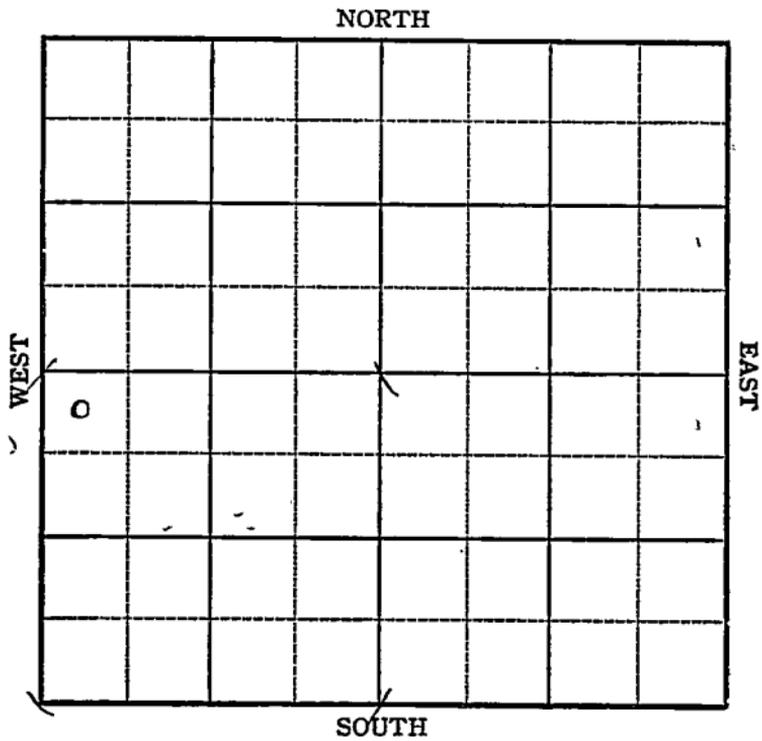

Sec. 18 Twp. 21 R. 12-W

Well No. #1 Welsh A Farm


~~W. P. Faulkner et al~~ R.M. SIEGFRIED Company

330 Ft. from N. Line

_____ Ft. from S. Line

_____ Ft. from E. Line

330 Ft. from W. Line

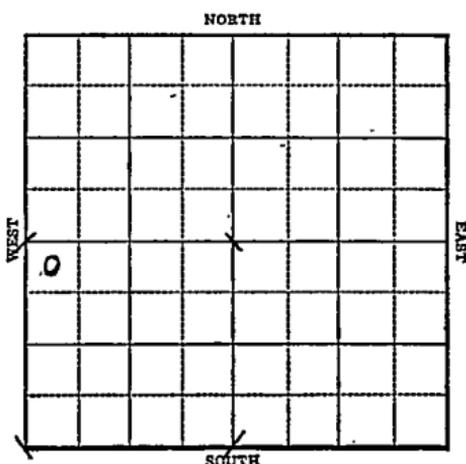

Elev. 1862' R E P O R T

1943

9/15 Location

9/22 "

9/29 "

10/6 "

10/13 "

10/20 Derrick

10/27 10" @ 285'
WOC.

11/3 Drlg. 1950'

11/10 Drlg. 2760'

11/17 2760' SD

11/24 Drlg 2960'

12/1 Lans 3277

Arb 3554

TD 3563 Sat

5" @ 3554

RUST

12/8 "

12-15 "

12/22 2500 oil in 7 hrs
Swb 100' oil in 5 hrs.

12/29 " "

1944

1-5 " "

1-12 " "

1/19 " 2

OVER

1944
 1/26 500' acid
 2/2 " "
 2/8 1000 acid Est 300 bbls oil a day
 2/15 " " " " "
 2/23 " " " "
 3/1 " " "
 3/8 " " "
 3/15 5" @ 3554
 1500 acid
 Arb. 3554
 TD 3563
 Pump 306 Pot
 Gravity 38.0

COMPLETED

1953 O.W.W.O.
 10/7 KC 3277', Arb 3554'
 5" @ 3554'
 OTD 3563'
 SP 3500
 30/ 3399-3404 2500 A
 S/ 2 gfph CO to 3350 24/ 3338-42
 1000 A Wtr.
 DD 3590'
 10/14 Oil well TD 3617' KC 3277'
 Arb. 3554' 5" @ 3554 OTD 3563'
 SP 3500 30/3399-3404 2500 A
 S/2 GFPH CO to 3350 24/3338-42
 1000 A wtr. DD 3590 DD 3617
 Comp. 10 BOPD 50 BW

COMPLETED

KANSAS

Map No. 46 Sec. 18 Twp. 21 R. 12W

Well No. 1 Welsh

W. P. Faulkner et al. Company

FIRST REPORT Contractor

NW SW


SECTION PLAT

330 Ft. from N. Line

_____ Ft. from S. Line

_____ Ft. from E. Line

330 Ft. from W. Line

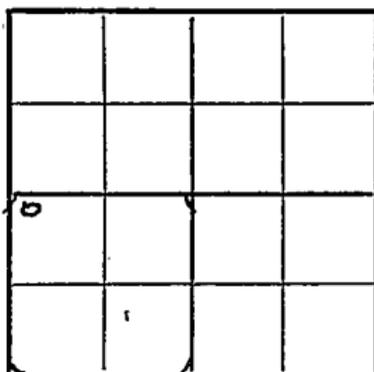

Wildcat

Location X

Rig up _____

Drilling and Remarks:

RECORD

Cased _____ in., _____ ft.

Sand _____

Gas _____

Oil _____

Total Depth _____

PRODUCTION

1st 24 hrs: Nat. _____

1st 24 hrs. after shot _____

Gas _____ Cu. Ft.

Dry Hole _____

Abandoned _____

Date

SEP 15 1943 19

S. J. LEWIS Scout

[Handwritten scribble]

Misc Small Maps
Cards
Tracing
France Map
Scarborough Map
Moody Map
Geological Dept.
Moody Flat Book

[Handwritten scribbles and signatures over the table]

KANSAS

Map No. 76 Sec. 18 Twp. 21 R. 12W

Well No. 1 Welsh

W. P. Faulkner et al. Company

COMPLETED Contractor

NW SW

SECTION PLAT

330 Ft. from N. Line

_____ Ft. from S. Line

_____ Ft. from E. Line

330 Ft. from W. Line

o			

James Pool

Location _____

Rig up _____

Drilling and Remarks:

Cr 3554
5' @ 3554
1500 @ acid
Pump 306 ft.

38° SW

RECORD

Cased _____ in., _____ ft.

Sand _____

Gas _____

Oil _____

Total Depth 3563

PRODUCTION

1st 24 hrs. Nat. _____

1st 24 hrs. after shot _____

Gas _____ Cu. Ft.


Dry Hole _____

Abandoned _____

Date

MAR 15 1944 19

S. J. LEWIS Scout

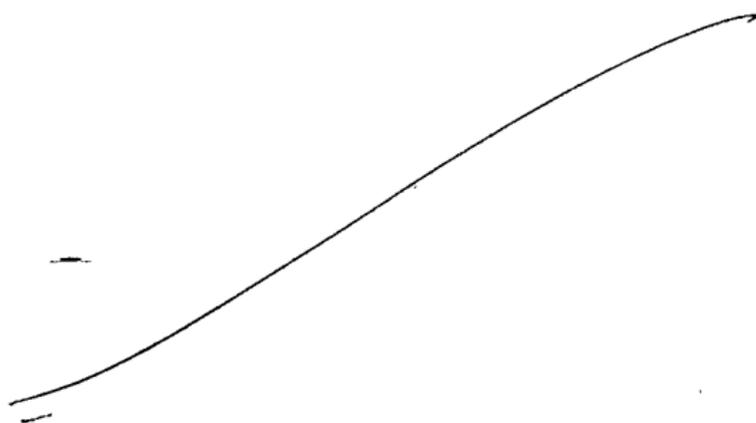

Misc. Small A. r.	<i>DM</i>
Cards	<i>Beverly</i>
Tracing	<i>M E L</i>
France Map	<i>✓</i>
Scarborough Map	<i>M E L</i>
Moody Map	<i>M E L</i>
Geological Dept.
Moody Plat Book	

O.W.W.O.

County Stafford State Kansas

Sec. 18 (Blk. Twp.) 21 (Sur. Rge.) 12W Map No.

Operator R. M. Siegfried

Well No. 1 Farm Welsh "A"

Elev. 1862 Location NE 1/4 SW

330 Ft. From N Line SW

330 Ft. From W Line Quarter

Ist. Report OCT 7 1953

Completion _____

Remarks _____



Spudding Date _____

Drlg. Data _____

KC 3277 Arb. 3554 5" @ 3554 OTD 3563

SP 3500 30/ 3399-3404 2500 A

S/ 2 gph CO. to 3350 24/ 3338-42

1000 A wtr. DD 3590

J. G. McGEHEE

2 1/2

OCT 9 1953

Scout Care
Law Small Map
Law Mail Map
Tracing
France Map
P - ce Map

53

Orig. Data

Street Cards	<i>mm</i>
Land Small Map	
Land Wall Map	<i>SP</i>
Tracings	
Finance Map	
Down Map	
Misc	

OCT 20 1953

Orig. Data