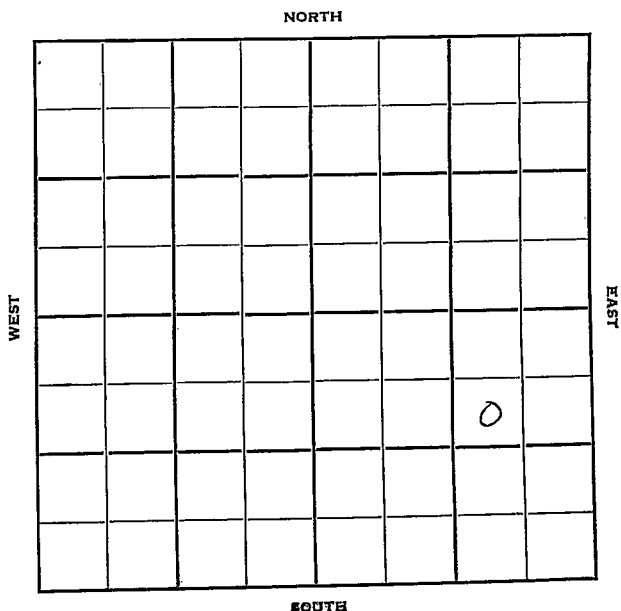


Section 18 Township 21 Range 12WWell No. #4 ClarkCompany Mid-States

Stafford

KANSAS

Sec. 18 Twp. 21 R. 12W

Well No. #4 Clark Farm

Mid-States Company

Harbar Drlg. Contractor

Sims Pool


990' Ft. from N. Line

 Ft. from S. Line

990' Ft. from E. Line

 Ft. from W. Line

SW NE SE

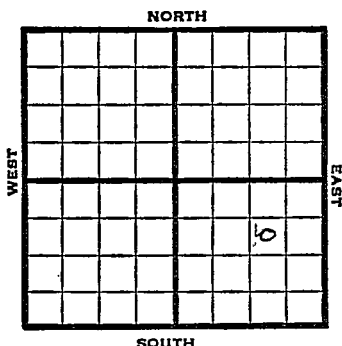

L 1950 Elev. 1864' REPORT

8/30 MIM

9/27 Spud 8-30-50

8" @ 308

Top 2834

Heeb 3112

Lans 3526

Cong 3479

Simp 3494

Arb 3527

5" @ 3530

TD 3543

FU 1000' oil S/7 boph for 6 hr

S/8 boph for 2 hr

1000 A no inc.

PB 3537

1500 A

S/9 $\frac{1}{2}$ boph for 8 hr

DP 3543

S/9 $\frac{1}{2}$ boph

Comp 321 bopd


Completed

COMPLETED



J. E. TYRA -

County Stafford State Kansas
 Sec. 18 (Blk. 21) (Sur. 12W) Map No.
 Operator Mid-States
 Well No. 4 Farm Clark
 Elev. 1864 Location SW NE SE

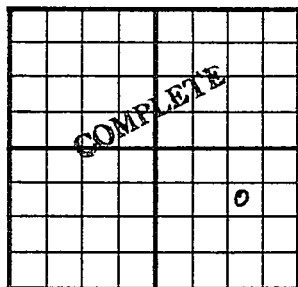

990 Ft. From N Line SE

990 Ft. From E Line Quarter

1st. Report

Completion SEP 27 1950

Remarks Sims Pool

Harbar Drlg. - Contr.

Spudding Date 8-30-50

Drlg. Data Oil well TD 3543

8" @ 308 Top. 2834 Heeb. 3112

Lans. 3256 Conn. 3479 Simp. 3494

Arb. 3527 5" @ 3530 TD 3543

FU 1000' oil S/ 7 boph for 6 hr.

S/ 8 boph for 2 hr. 1000 A no inc.

PB 3537 1500 A S/ 9½ boph for 8 hr.

DP 3543 S/ 9½ boph Comp. 321 bopd

J. E. TYRA