


Section 18 Township 21 Range 12W

Well No. #5 Clark

Company Mid-States Oil

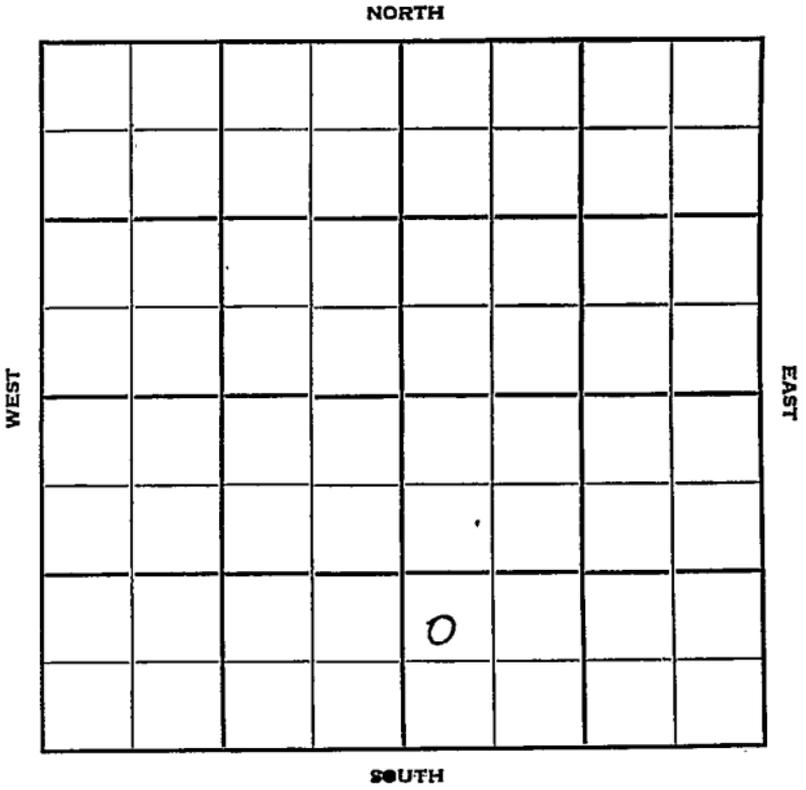

Sec. 18 Twp. _____ R. _____

Well No. #5 Clark Farm _____

Mid-States Oil Company _____

B & R Drlg. - Contr. Contractor _____


_____ Ft. from N. Line

990' Ft. from S. Line

_____ Ft. from E. Line

330' Ft. from W. Line

NW SW SE

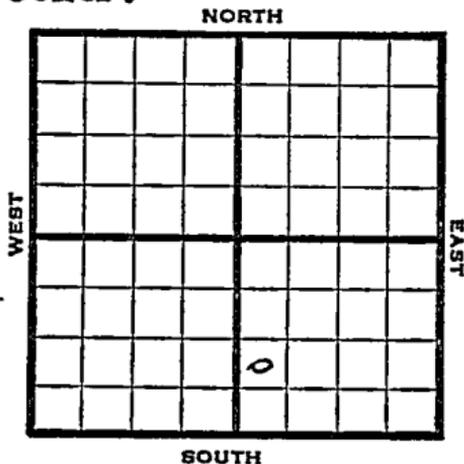

1950

Elev 1866' REPORT

12/27

Drlg. Spud 12-23-50

1951
1/24

8" @ 300
Heeb 3128 Br lime 3256
Lans 3273 Cong 3490
Simp 3504 Arb 3545
5" @ 3546
FU 300' oil
TD 3549
FU 700' oil
S/4 boph for 5 hr
500 A
Comp 356 bopd
Completed
COMPLETED

