


Section 18 Township 21 Range 12 W

Well No. #6 Clark

Company Mid-States

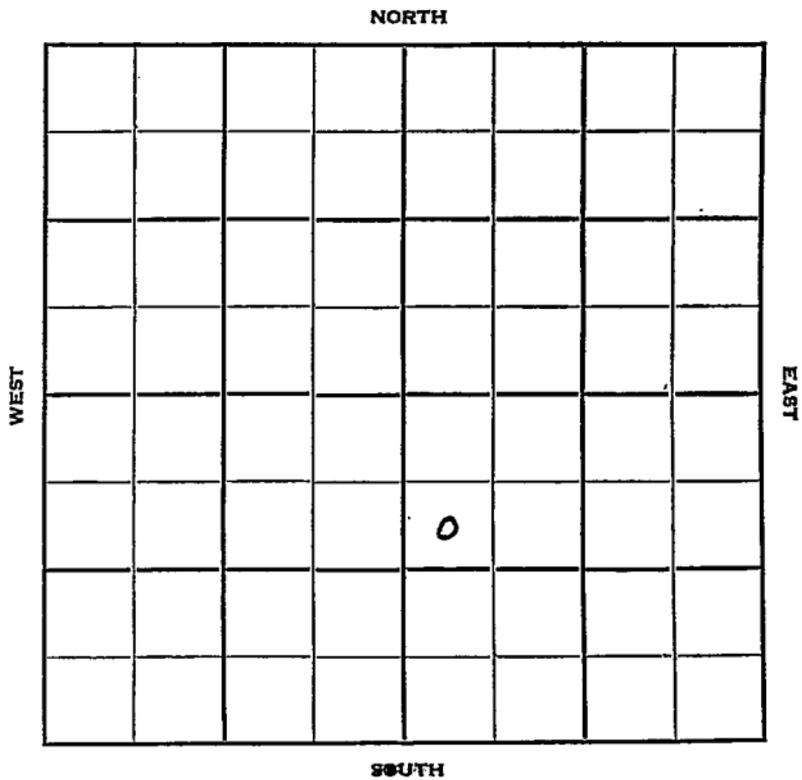

Sec. 18 Twp. 21 R. 12W

Well No. #6 Clark Farm

Mid-States Company

Harber Drlg. Contractor

Mueller Pool


990' Ft. from N. Line

\_\_\_\_\_ Ft. from S. Line

\_\_\_\_\_ Ft. from E. Line

330' Ft. from W. Line

SW NW SE

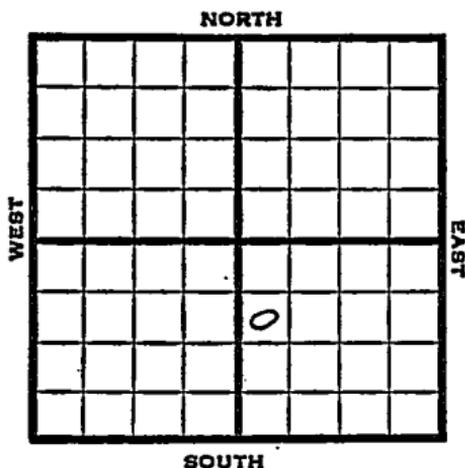

1951

Elev. 1863' REPORT

1/31

Location

3/7

Spud 2-5-51

Oil well TD 3587

8" @ 280

Heeb. 3132 Lans. 3260 Cong. 3499

Viola 3510 Simp. 3540 Arb. 3581

DST 3583-86 open 1/2 hr. Rec. 62' O&GCM

TD 3586'

5" @ 3582

28 goph DD 3587 9/3583-86

25 goph 500 A S/ 10 boph

Comp. 271 bopd

**COMPLETED**



