


Section 18 Township 21 Range 12 W

Well No. # 2  
# 1 Welsh "B"

Company Campbell & Kuhn

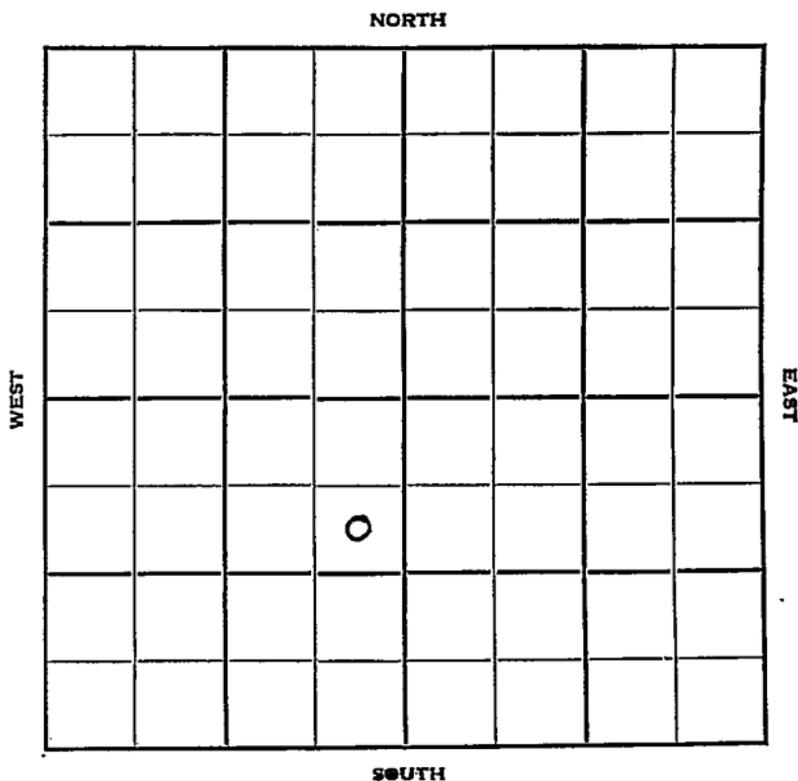

Stafford

KANSAS

Sec. 18 Twp. 21 R. 12 W

Well No. ~~#1~~ #2 Welsh "B" Farm

Campbell & Kuhn Company

Contractor


Mueller Pool

990 Ft. from N. Line

\_\_\_\_\_ Ft. from S. Line

330 Ft. from E. Line

\_\_\_\_\_ Ft. from W. Line

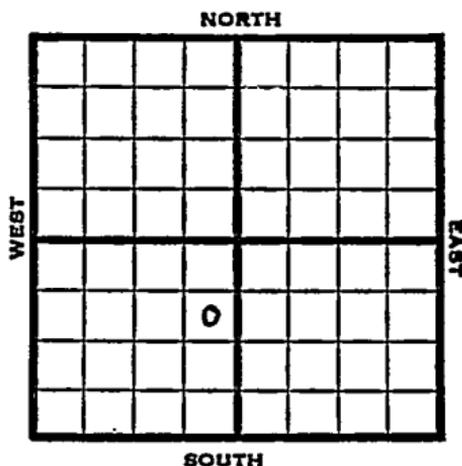

SE NE SW

1951

Elev. 1864' REPORT

3/21

R U R

1952

1/16

Spud 3-17-51

D & A TD 3636' Anhy 720'

8" @ 276 Br. lime 3261'

Lans. 3278' Cong. 3521' Viola 3532'

Simp. 3559' Arb. 3609-16' TD

5" @ 3609 DD 3635' HFW

D & A

**ABANDONED**



KANSAS  
KANSAS

Map No. \_\_\_\_\_ Sec. 18 Twp. 21 R. 12W

Well No. 2 Welsh "B"

Campbell & Kuhn Company

CORRECTION Contractor

SE NE SW

SECTION PLAT

990 Ft. from N. Line

\_\_\_\_\_ Ft. from S. Line

330 Ft. from E. Line

\_\_\_\_\_ Ft. from W. Line

|  |  |  |  |
|--|--|--|--|
|  |  |  |  |
|  |  |  |  |
|  |  |  |  |
|  |  |  |  |

Stafford County

Location \_\_\_\_\_

Rig up \_\_\_\_\_

Drilling and Remarks:

Reported

#1

RECORD

Cased \_\_\_\_\_ in., \_\_\_\_\_ ft.

Sand \_\_\_\_\_

Gas \_\_\_\_\_

Oil \_\_\_\_\_

Total Depth \_\_\_\_\_

PRODUCTION

1st 24 hrs. Nat. \_\_\_\_\_

1st 24 hrs. after shot \_\_\_\_\_

Gas \_\_\_\_\_ Cu. Ft.

Dry Hole \_\_\_\_\_

Abandoned \_\_\_\_\_

Date

MAR 28 1951

19

J. E. TYRA

Scout

