


Section 18 Township 21 Range 12 W

Well No. # 3 J. Welsh

Company R. M. Siegfried

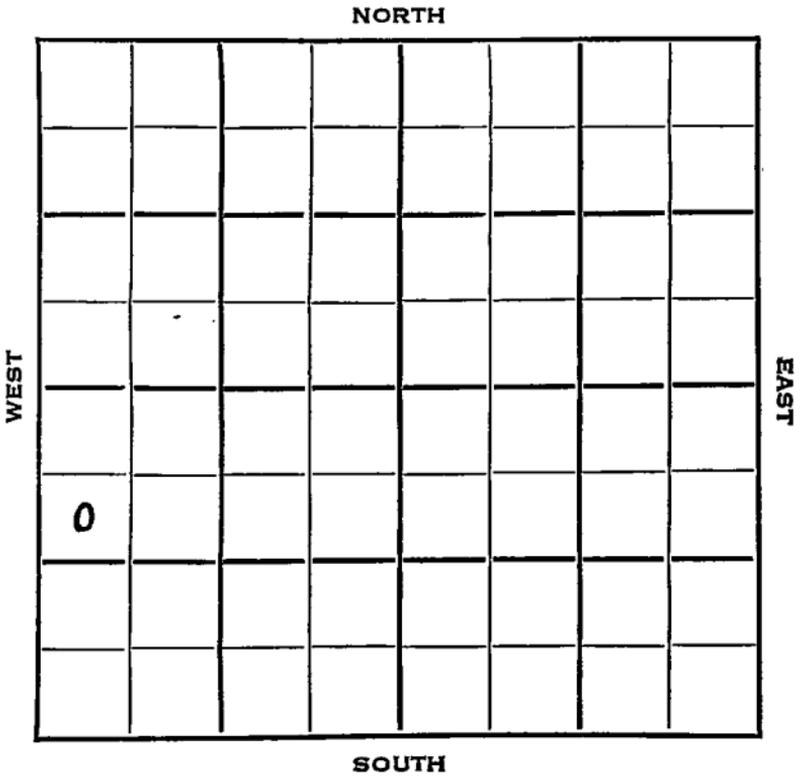

Sec. 18 Twp. 21 R. 12W

Well No. #3 J. Welsh Farm

R.M. Siegfriend Company

Buick Drlg. Contractor

Syms Pool


990 Ft. from N. Line

_____ Ft. from S. Line

_____ Ft. from E. Line

330 Ft. from W. Line

SW NW SW

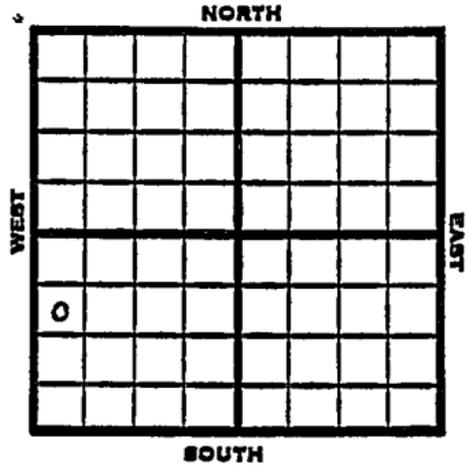

1953 Elev. 1860' REPORT

- 8/5 Spud 7-29-53
8" @ 287'
Anhy 703'
Drlg 1850'
- 8/12 Heeb 3125, Br li 3241, Lans 3268
DST 3387-97, 1 hr., 30' oil, 45'
O&GCM, 1190#
DST 3426-53
- 8/19 NR
- 9/16 NR
- 9/23 Spud 7-29-53
Oil Well
TD 3670'
8" @ 287'
Anhy 703, Heeb 3125, Br. Lime 3241, La-
ns 3268,
DST 3387-97 opn 1 hr, rec 30' oil,
45' o & gcm 1190#.
DST 3426-53
TD 3670'
5" @ 3669'
CO to 3659 30/ 3546-52 FU 1100'
oil 6 hr. S/ 2 boph 5 hr. 30/
3552-57 FU 1455' oil 4 hr. S/ 2½ boph
4 hr. 500 A S/ 9½ boph 12hr. Arb

OVER

1953

Information brought forward.

9/23 3546, 2000 A 8 boph 8 hr.
DST 3426-53 opn 1 hr, rec 345' wtr,
DST 3556-64 opn 1 hr, rec 2420' oil
735# Simp 3506
DST 3565-80 opn 1 hr, rec 2600' oil
700#
Comp. 508 bopd.

COMPLETED

AUG 7 1953

Scout Cards
Land Small Map
Land Wall Map
Tracings
Trance Map
Pierce Map
Misc.

Drig. Data

