

Section 18 Township 21 Range 13W

Well No. #1 Brown

Company Petroleum, Inc.

Wildcat

NORTH

WEST

EAST

		.					
		0					

SOUTH

Sec. 18 Twp. 21 R. 13W

Well No. #1 Brown Farm

Petroleum, Inc. Company


Wildcat (Petroleum, Inc. Contr.)

_____ Ft. from N. Line

330' Ft. from S. Line

990' Ft. from E. Line

_____ Ft. from W. Line

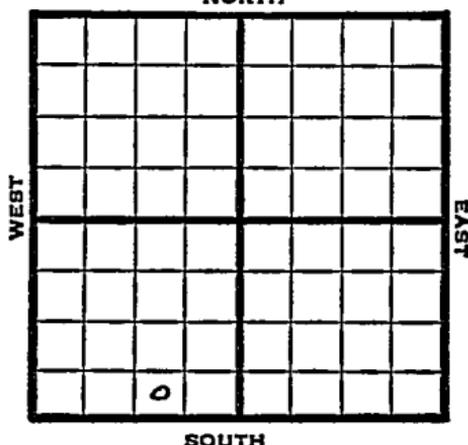

SW SE SW

1949 Elev 1917' REPORT

12/7 8' @ 325'
Drlg. 650'

12/14 Lansing 3351'
Viola 3588'
Arbuckle 3674'

12/21 TD 3679'
5" @ 3675
Swb 2 bbls oil PH

12/28 "

1950
2/8 TD 3679'
8" @ 325'
5" @ 3675'
Lans 3551'
Viola 3588'
Simp 3617'
Arb. 3674'
P 52 BOPD
Comp

COMPLETED

Map No. _____ Sec. 18 Twp. 21 R. 13W

Well No. 1 Brown

_____Petroleum Inc._____
 _____ Company

_____Petroleum Inc._____
 _____ Contractor

SW SE SW

**FIRST REPORT
 SECTION PLAT**

_____ Ft. from N. Line

330 Ft. from S. Line

990 Ft. from E. Line

_____ Ft. from W. Line

Stafford County

Location _____

Rig up _____

Drilling and Remarks:

8" @ 325

drlg. 650

RECORD

Cased _____ in., _____ ft.

Sand _____

Gas _____

Oil _____

Total Depth _____

PRODUCTION

1st 24 hrs. Nat. _____

1st 24 hrs. after shot _____

Gas _____ Cu. Ft.

Dry Hole _____

Abandoned _____

Date

DEC 7 1949

S. J. LEWIS Scout

Kansas

Map No. _____ Sec. 18 Twp. 21 R. 13W

Well No. 1 Brown

Petroleum Inc.

Company

Contractor

SW SE SW

E. 1917
SECTION PLAT

_____ Ft. from N. Line

330 _____ Ft. from S. Line

990 _____ Ft. from E. Line

_____ Ft. from W. Line

	COMPLETE		

Stafford County

Location _____

Rig up _____

Drilling and Remarks:

8" @ 325

5" @ 3675

Lana 3551

Viola 3588

Simp 3617

Art 3674

P 52 BOPD

RECORD

Cased _____ in., _____ ft.

Sand _____

Gas _____

Oil _____

Total Depth 3679

PRODUCTION

1st 24 hrs. Nat. _____

1st 24 hrs. after shot _____

Gas _____ Cu. Ft.

Dry Hole _____

Abandoned _____

Date

FEB 8 1950 19

J. E. TYRA Scout