


Section 18 Township 21 Range 13W

Well No. #2 Brown


Company Petroleum, Inc.

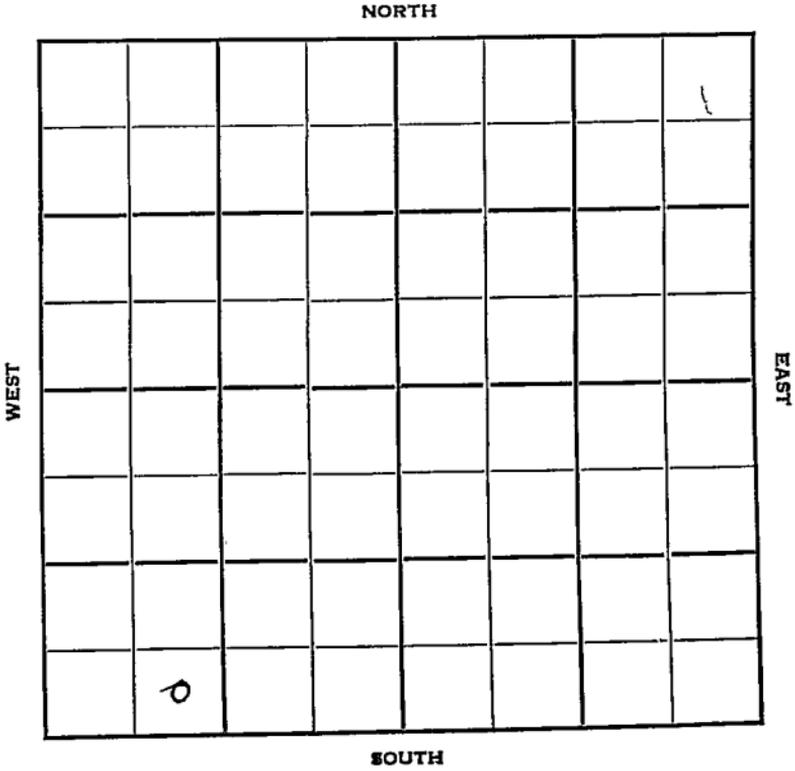

Sec. 18 Twp. 21 R. 13W

Well No. #2 Brown Farm \_\_\_\_\_  
Petroleum, Inc. Company \_\_\_\_\_  
 Contractor \_\_\_\_\_

\_\_\_\_\_ Ft. from N. Line  
330' Ft. from S. Line  
 \_\_\_\_\_ Ft. from E. Line  
990' Ft. from W. Line  
 SE SW SW

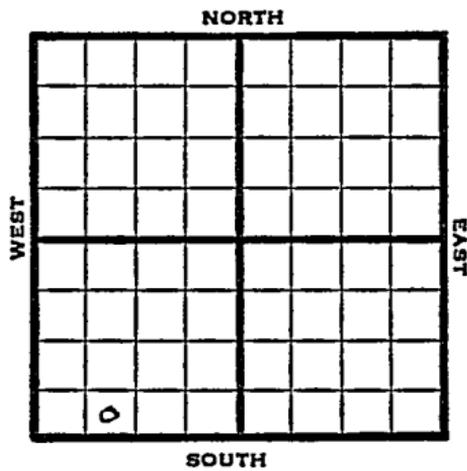

1950 Elev. 1923' REPORT

3/29 Spud 3-21-50  
 8" @ 226'  
 Anhy 810'  
 Heeb. 3228'  
 Toronto 3247'  
 Br. Line 3347'  
 Lans. 3360'  
 TD 3398'

4/5 TD 3644'  
 8" @ 226  
 Lans 3364'  
 Cong 3605'  
 Viola 3610'  
 Simp 3650'  
 Arb. 3634'  
 D&A  
 Aband.

**ABANDONED**



Kansas

Map No. \_\_\_\_\_ Sec. 18 Twp. 21 R. 13W

Well No. 2 Brown

Petroleum Inc. Company

Contractor

SE SW SW

*E. 1923*  
SECTION PLAT

\_\_\_\_\_ Ft. from N. Line

330

\_\_\_\_\_ Ft. from S. Line

\_\_\_\_\_ Ft. from E. Line

990

\_\_\_\_\_ Ft. from W. Line

ABANDONED			
o			

Stafford County

Location \_\_\_\_\_

Rig up \_\_\_\_\_

Drilling and Remarks:

*8" @ 226  
Lans 3364  
Cong 3605  
Viola 3610  
Simp 3650  
arb. 3634  
D + A*

RECORD

Cased \_\_\_\_\_ in., \_\_\_\_\_ ft.

Sand \_\_\_\_\_

Gas \_\_\_\_\_

Oil \_\_\_\_\_

Total Depth 3644

PRODUCTION

1st 24 hrs. Nat. shut in

1st 24 hrs. after shot shut in

Gas 0.11 M. Cuft.

Dry-Hole shut in

Abandoned shut in

Date APR 5 1950

J. E. TYRA

Scout