


Section 18 Township 21 Range 13-WWell No. #3 Brown "A"Company Petroleum Inc.

NORTH

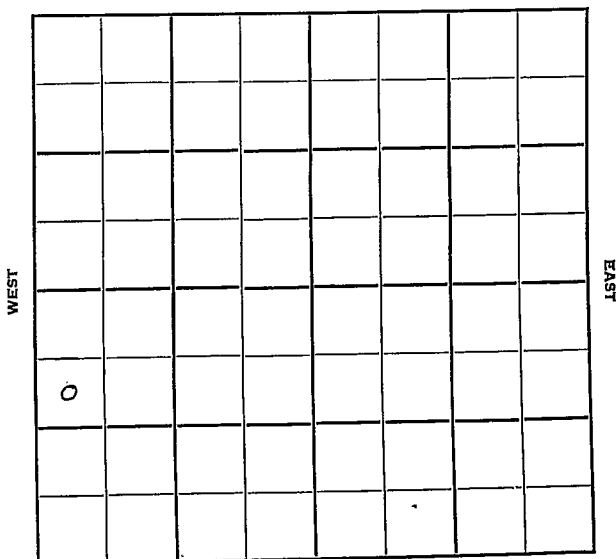

SOUTH

Stafford

KANSAS

Sec. 18 Twp. 21 R. 13W ✓

Well No. #3 Brown "A" Farm

Petroleum, Inc. Company

Contractor


990' Ft. from N. Line

_____ Ft. from S. Line

_____ Ft. from E. Line

330' Ft. from W. Line

SW NW SW

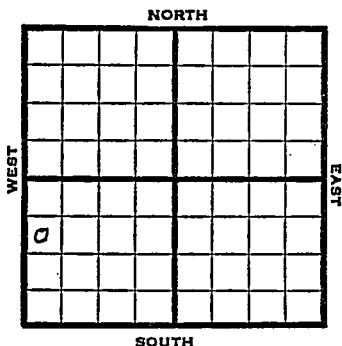

1950

Elev 1919

REPORT

7/5 Spud 7-3-50
8-5/8" @ 245'
WOC

7/19 8 5/8" @ 245
Anhy 814 Heeb 3224
Toronto 3245 Br lime 3346
Lans 3358 Viola 3594
DST 3582-3606, opn 1/2 hr red 3' mud
Simp 3622
DST 3647-70, opn 1/2 hr rec 5' mud
Arb 3680
DST 3682-86, opn 1 3/4 hr, rec 300' wtr
TD 3686
D&A

ABANDONED

KansasMap No. _____ Sec. 18 Twp. 21 R. 13WWell No. 3 Brown "A"

_____ Petroleum Inc. _____ Company

_____ Contractor


SW NW SW

SECTION PLAT

990 Ft. from N. Line

_____ Ft. from S. Line

_____ Ft. from E. Line

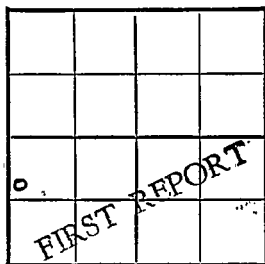330 Ft. from W. LineStafford County

Location _____

Rig up _____

Drilling and Remarks:

Spud 7-3-50

8 5/8" C 24.5

WOC

RECORD

Cased _____ in., _____ ft.

Sand _____

Gas _____

Oil _____

Total Depth _____

PRODUCTION

1st 24 hrs. Nat. _____

1st 24 hrs. after shot _____

Gas _____ Cu. Ft.

Dry Hole _____

Abandoned _____

Date

JUL 5 1950 19J. E. TYRA Scout

1. 2. 3. 4. 5. 6. 7. 8. 9. 10.

1. 2. 3. 4. 5. 6. 7. 8. 9. 10.

1. 2. 3. 4. 5. 6. 7. 8. 9. 10.

1. 2. 3. 4. 5. 6. 7. 8. 9. 10.

1. 2. 3. 4. 5. 6. 7. 8. 9. 10.

1	2	3	4	5	6	7	8	9	10
1	2	3	4	5	6	7	8	9	10
Supplement

1. 2. 3. 4. 5. 6. 7. 8. 9. 10.

1950

Scout Cards	☒
Land Small Map	☒
Land Wall Map	☒
Troop Book	☒
France Map	☒
Pierce's Handbook	☒
Misc.	☒

KANSASMap No. _____ Sec. 18 Twp. 21 R. 13WWell No. 3 Brown "A"Petroleum Inc.

Company

Contractor

SW NW SW

El. 1919
SECTION PLAT990 Ft. from N. Line

_____ Ft. from S. Line

_____ Ft. from E. Line

330 Ft. from W. Line

Stafford County

Location _____

Rig up _____

Drilling and Remarks:

8 5/8" @ 245

Anhy 814

Heeb. 3224

Toronto 3245

Br. time 3346

Lans. 3358

Viola 3594

RECORD

Cased _____ in., _____ ft.

Sand _____

Gas _____

Oil _____

Total Depth 3586

PRODUCTION

1st 24 hrs. Nat. _____

1st 24 hrs. after shot _____

Gas _____ Cu. Ft.

Dry Hole _____

Abandoned _____

Date

JUL 19 1950

19

J. E. TVPA Scout


SETH 3

243



1. 2. 84

WILLIAM H. HARRIS

4. 28 255

DA 3

Rec. 300, water

open 1-3/4 hr.

68-2892-154

Arp. 3680

Rec. 5: mud

• $\frac{2}{T}$ open.

DST 3647-765

Stamp • 3622

Rec. 3 - mud

open $\frac{2}{3}$ hr.

DST 3582-3606

Scout Cards

Land- Small Map

Land Wall Map

Tracings

France Map

Pierce Map

Misc.