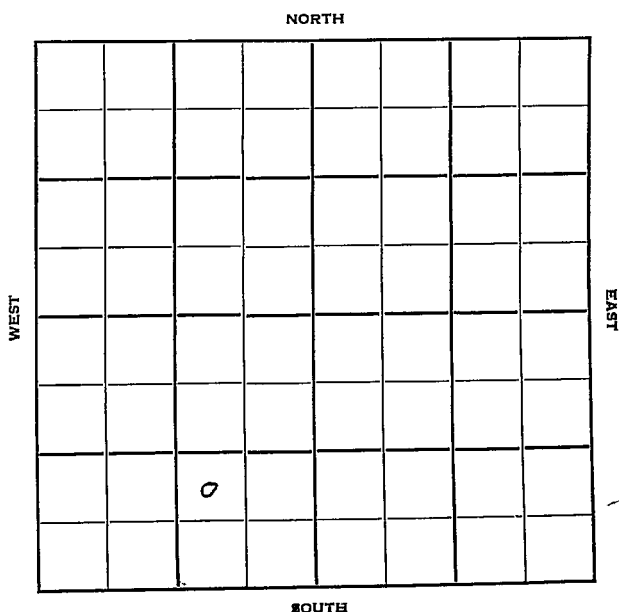


Section 18 Township 21 Range 13WWell No. #4 Brown "A"Company Petroleum, Inc.

Sec. 18 Twp. 21 R. 13W

Well No. #4 Brown "A" Farm

Petroleum Inc. Company

Garvey - Contr. Contractor

Pundsack Pool


990' Ft. from N. Line

 Ft. from S. Line

990' Ft. from E. Line

 Ft. from W. Line

NW SE SW

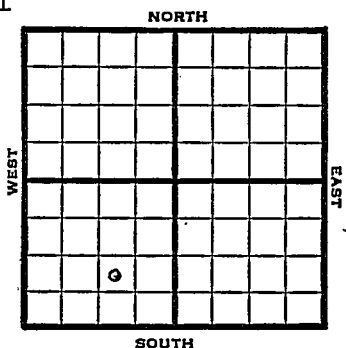


1950 Elv. 1918' REPORT

10/4 Spud 10-2-50
8-5/8" @ 227'
WOC

10/11 Spud 10-2-50
D&A TD 3401
8-5/8 @ 227
Heeb 3227'
Br Lime 3351'
Lans. 3363'
TD 3401'
D&A

ABANDONED

J. E. TYRA

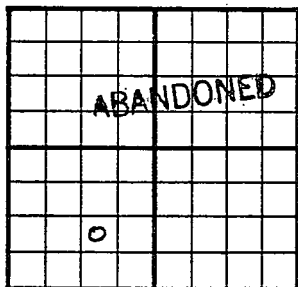County Stafford State KansasSec. 18 (Blk.
Twp.) 21 (Sur.
Rge.) 13W Map No.Operator Petroleum Inc.Well No. 4 Farm Brown "A"Elev. 1918 Location NW SE SW990 Ft. From S Line SW990 Ft. From E Line Quarter1st. ReportCompletion OCT 11 1950Remarks Pundsack PoolGarvey Oil - Contr.Spudding Date 10-2-50Drlg. Data D & A TD 34018 5/8" @ 227 Heeb. 3227 Br. lime 3351Lans. 3363 TD 3401 D & A

J. E. TYRA