

KANSAS


Stafford

FORM 51 25M 3-49 PETROL

Section 18 Township 21 Range 13-W

Well No. #1 E. Brown

Company Stanolind

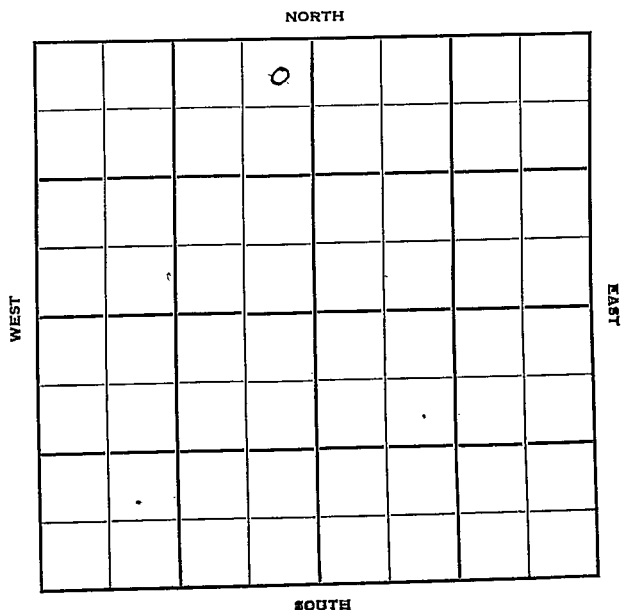

Stafford KANSAS

Sec. 18 Twp. 21 R. 13W

Well No. #1 E. Brown Farm

Stanolind Company

Noble Drlg. - Contr. Contractor

Gates Pool


330' Ft. from N. Line

Ft. from S. Line

330' Ft. from E. Line

Ft. from W. Line

NE NE NW

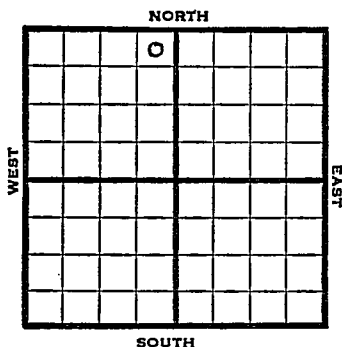

1950	Elev. 1915'	REPORT
9/20	Location	
10/18	Spud 10-4-50 D&A TD 3672' 8-5/8" @ 824' Heeb. 3216' Lans. 3343' Arb. 3648' DST 3648-52 opn 1 hr Rec. 100' sulphur wtr TD 3672' D&A ABANDONED	

County Stafford State KansasSec. 18 (Blk. Twp.) 21 (Sur. Rge.) 13W Map No. _____Operator StanclindWell No. 1 Farm E. BrownElev. _____ Location NE NE NW

		0				

FIRST REPORT

330 Ft. From N Line NW330 Ft. From E Line Quarter1st. Report SEP 20 1950


Completion _____

Remarks _____

Spudding Date _____

Drlg. Data Gates PoolLocation _____

J. E. TYRA

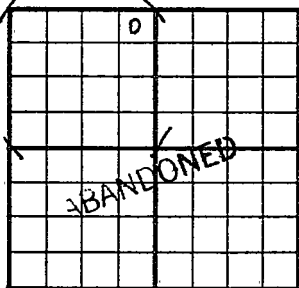County Stafford State KansasSec. 18 (Blk.
Twp.) 21 (Sur.
Rge.) 13W Map No. _____Operator StanolindWell No. 1 Farm BrownElev. 1915 Location NE NE NW330 Ft. From N Line NW330 Ft. From E Line Quarter

1st. Report _____

Completion OCT 18 1950Remarks Gates PoolNoble Drlg. - Contr.Spudding Date 10-4-50Drlg. Data D & A TD 36728 5/8" @ 824 Heeb. 3216 Lans. 3343Arb. 3648 DST 3648-52 open 1 hr.Rec. 100' sulphur water TD 3672D & A