


Section 18 Township 21 Range 13 W

Well No. # 2 A. Fischer "A"

Company Stanolind

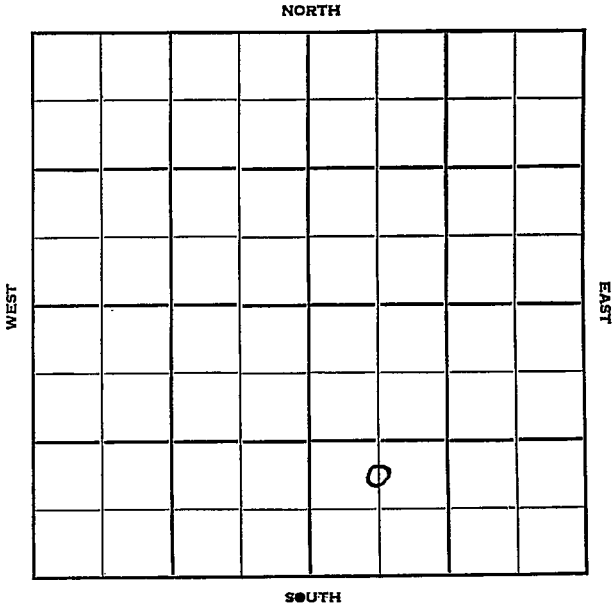

Stafford

KANSAS 23W

Sec. 18 Twp. 21 R.

Well No. #2 A. Fischer "A" Farm


Stanolind Company

Iron Drlg. - Contr. Contractor

Ft. from N. Line

NORTH

990' Ft. from S. Line

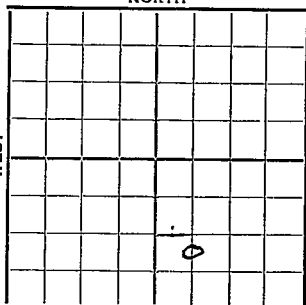

Ft. from E. Line

660' Ft. from W. Line

C N L SW SE

SOUTH

1952 Elev. 1915' REPORT

2/20 Spud 2-14-52  
Anhy 810  
8" @ 818

3/5 Drlg. 1929'  
Spud 2-14-52  
D&A TD 3723'  
Anhy 810 8" @ 818 Lans. 3358  
DST 3500-3510 open 1 hr. rec. 50' OCM  
Simp. 3656 Arb. 3669'  
DST 3698-3702 open 1 hr. rec. 15' OCM  
DST 3699-3704 open 1 hr. rec. 24' OCM  
DST 3700-3706 open 1 hr. rec. 30' mud  
DST 3699-3708 open 1 hr. rec. 30' Mud  
DST 3708-23 open 1 hr. rec. 180' muddy  
sul. wtr. TD 3723'  
D&A

**ABANDONED**



