


Section 18 **O.W.P.B** Township 21 Range 13W

Well No. #1 Fisher

Company Stanolind

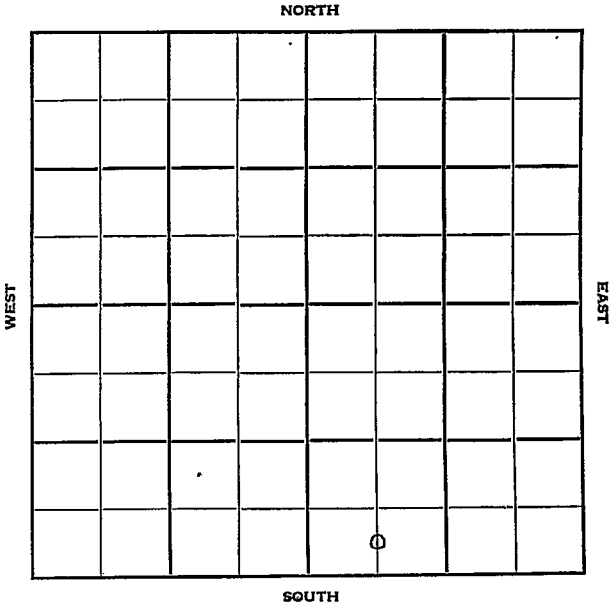

Stafford

KANSAS

Sec. 18 Twp. 21 R. 13 W

Well No. # 1 Fisher Farm

Stanolind Company

Iron Drlg. Contractor  
Punsack Pool


\_\_\_\_\_ Ft. from N. Line

330 Ft. from S. Line

\_\_\_\_\_ Ft. from E. Line

660 Ft. from W. Line

C S/2 SW SE

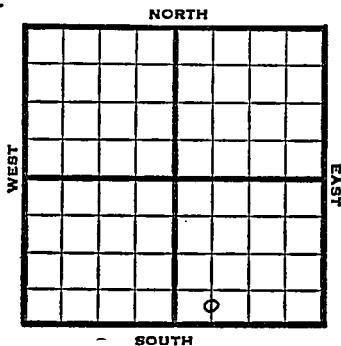

1951 Elev. 1914' REPORT

9/19 Location

10/31 Spud 9-19-51  
 Oil well TD 3692' 10" @ 817'  
 Heeb 3223' Br. lime 3342'  
 Lans. 3355'  
 DST 3480-98 open 1 hr. rec 210' HGCO  
 1980' gas  
 DST 3512-26 open 1/2 hr. rec 1' mud.  
 DST 3533-54 open 1 hr. rec 100' HO  
 & GCM  
 DST 3533-54 open 1 hr. rec 200' HOCM  
 Arb. 3686-92'  
 DST 3689-92 open 1 hr. rec 660' oil  
 7" @ 3685 TD 3692' S/8 BOPH  
 10 hr. 500 A S/17 BOPH  
 Comp. 494 BOPD

**COMPLETED**





O. W. P. B

FORM 513 SUNRAY

County Stafford Elev. \_\_\_\_\_  
 Sec. 18 Twp. 21 Rge. 13W  
 Company Stanolind Oil & G  
 FarmName Fischer No. 1

TOPS	DEPTH	LOG	DATUM	Loc. in Sec.
Anh.				C S $\frac{1}{2}$ SW SE
Tp.				OWPB
H.				
Tr.				
Dg.				
Bl.				
L.		3352		Geol. _____
K.C.				Contr. _____
B.K.C.				
Ce.				
C.				
M.				
M.				Pool _____
K.				
Mz.				
Mo.				
V.				
S.				
S.				
A.		3683		
R.				
Pe.				FIRST REPORT
G.				
T.D.				

**COMPLETE**  
 NO/14/56  
 FIRST REPORT

Date Comm. \_\_\_\_\_  
 OTD 3692 7" @ 3685 PB 3670  
 20/ 3517-116 1500 A S/ 3 boph  
 32/ 3191-3502 2000 A S/ 15 boph  
 Conn. 351 band

NOV 5 1956

Handwritten signature and number 3