


Section 18 Township 21 Range 13 W

Well No. # 1 Nellie Harms

Company Harms & Knight

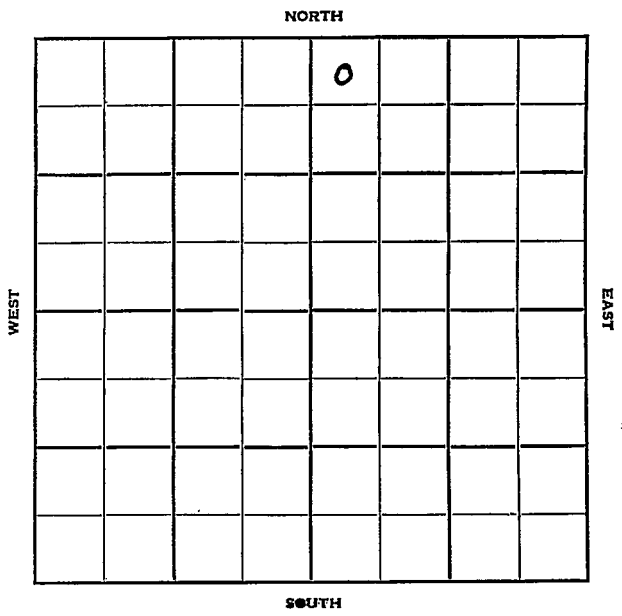

Sec. 18 Twp. 21 R. 13 W

Well No. # 1 Nellie Harms Farm

Harms & Knight Company

Harms & Knight Contractor


330 Ft. from N. Line

Ft. from S. Line

Ft. from E. Line

330 Ft. from W. Line

NW NW NE

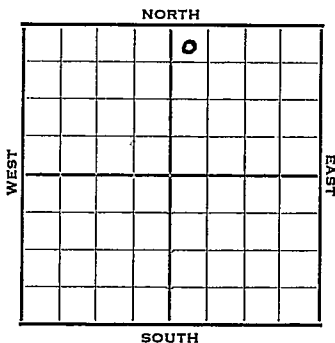

1952

Elev. 1913' REPORT

3/26

Spud 3-24-52
8" @ 297' WOC

4/1

Anhy 810' Heeb 3214'
Drlg. 3320'

4/9

Spud 3-24-52
D & A TD 3713' 8" @ 297
Anhy 810' Heeb 3214' Tor. 3235'
Br. lime 3332' Lans. 3344'
DST 3462-73 open 45 min, rec 4' mud
DST 3478-3511 open 1 1/4 hr. rec 45' SOCM
Viola 3579'
DST 3579-90 open 45 min. rec 115' mud
Simp. 3598' Arb. 3652'
TD 3713' D & A

ABANDONED

County Stafford State Kansas

Sec. 18 (Blk. Twp.) 21 (Sur. Rge.) 13W Map No.

Operator Harms & Knight

Well No. 1 Farm Nellie Harms

Elev. 1913 Location NW NW NE

ABANDONED

330 Ft. From N Line NE

330 Ft. From W Line Quarter

1st. Report

Completion APR 9 1952

Remarks

Harms & Knight - Contr.

Spudding Date 3-24-52

Drlg. Data D & A TD 3713

8" @ 297 Anhy 810 Heeb. 3214

Tor. 3235 Br. lime 3332 Lans. 3344

DST 3462-73 open 45 min. Rec. 4' mud

DST 3478-3511 open 1½ hr. Rec. 45' socm

Viola 3579 DST 3579-90 open 45 min.

Rec. 115' mud Simp. 3598 Arb. 3652

TD 3713 D & A