


Section 18 Township 21 Range 13-W

Well No. #1 Walters

Company Harry Gore

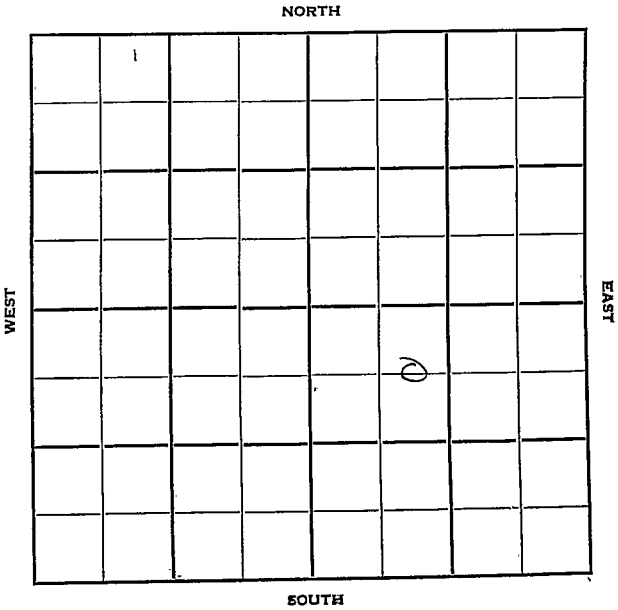

Sec. 18 Twp. 21 R. 13W ✓

Well No. #1 Walters Farm

Harry Gore Company

Contractor


**Gates**  
660' Ft. from N. Line

\_\_\_\_\_ Ft. from S. Line

\_\_\_\_\_ Ft. from E. Line

990' Ft. from W. Line

C E L NW SE

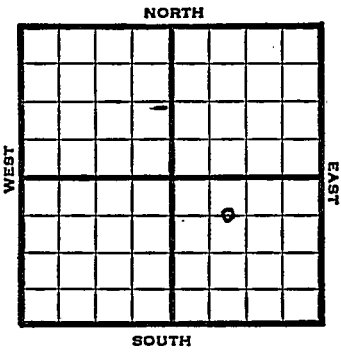

1950

Elev 1914 REPORT

8/16

RUR

8/30

Spud 8-15-50

8" @ 431

Heeb 3247

Br line 3365

KC 3377

Cong 3618

Simp 3654

TD 3883

D&A

**ABANDONED**

County Stafford State Kansas

Sec. 18 (Blk. Twp.) 21 (Sur. Rge.) 13W Map No.

Operator Harry Gore

Well No. 1 Farm Walters

Elev. \_\_\_\_\_ Location C E L NW SE


660 Ft. From N Line SE

990 Ft. From W Line Quarter

1st. Report AUG 16 1950

Completion \_\_\_\_\_

Remarks \_\_\_\_\_

Stanolind farmout

Spudding Date \_\_\_\_\_

Drlg. Data \_\_\_\_\_

R U R

County Stafford State Kansas

Sec. 18 (Blk. 21) (Sur. 13W) (Twp.) (Rge.) Map No.

Operator Harry Gore

Well No. 1 Farm Walters

Elev. 1914 Location C E L N W S E


**ABANDONED**

660 Ft. From N Line SE

990 Ft. From W Line Quarter

Ist. Report \_\_\_\_\_

Completion AUG 30 1950

Remarks \_\_\_\_\_

Gates Pool

Spudding Date 8-15-50

Drlg. Data D & A TD 3883

8" @ 431 Heeb. 3247 Br. line 3365

KC 3377 Cong. 3618 Simp. 3654

TD 3883 D & A

J. E. TYRA