


DX 78-1

Pawnee KANSAS

Section 18 Township 21 Range 15W

Well No. 1 Dufford "B"

Company G-M-R Oil

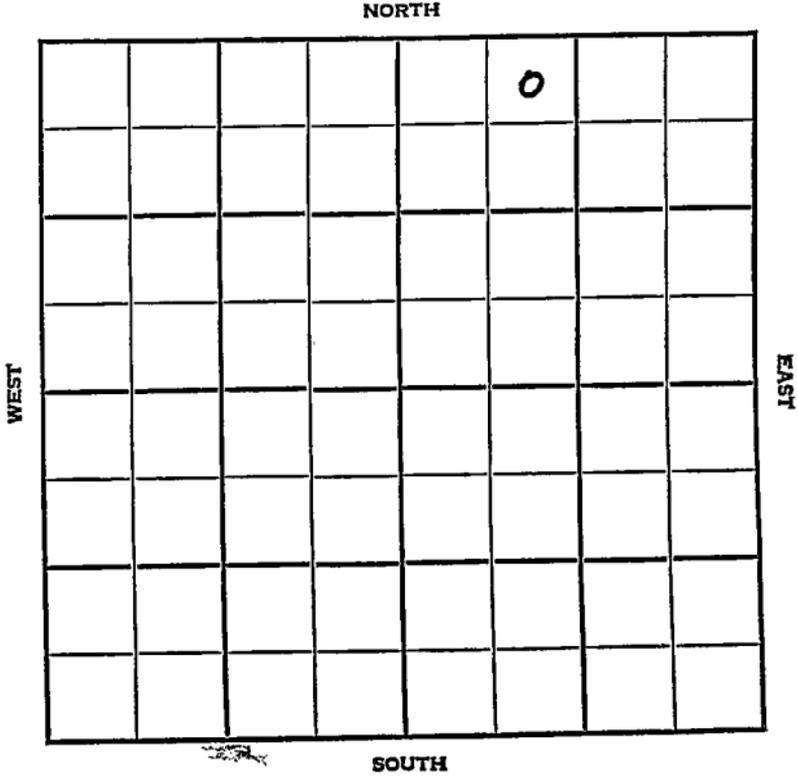

**Pawnee KANSAS**

SEC.	TWP.	R.
18	21	15W

WELL NO. **1 Dufford "B"** FARM

COMPANY **G-M-R Oil**

CONTRACTOR **G-M-R**


**Sweeney Pool**

330 Ft. from N. Line

\_\_\_\_\_ Ft. from S. Line

\_\_\_\_\_ Ft. from E. Line

990 Ft. from W. Line

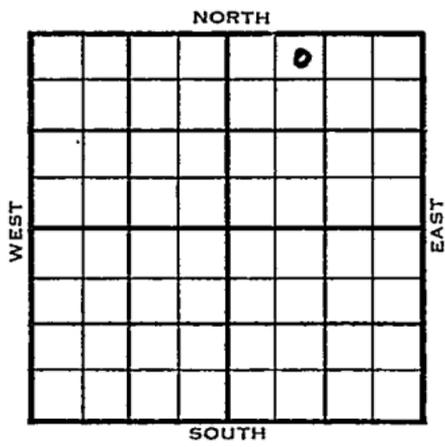

NE NW NE  
CSO Farmout

	ELEVATION	REPORT
1954	1959'	

8/25	Spud 8-18-54 8" @ 946' Drlg. 3062'
9/15	spud 8-18-54 - Gas Well TD 3837' 8" @ 946' Heeb 3332', Br lime 3430', Lans 3442', Cong 3725', Arb. 3806' DST 3824-32', opn 2 hrs., rec. 15' gcm, 1,400,000 cfg, TD 3832' 5" @ 3832' DD 3837' 3½ mcfg Comp. 3,500,000 c fgp <sup>d</sup>

**COMPLETED**


County Pawnee State Kansas

Sec. 18 (Blk. 21) (Sur. 15W) Map No.

Operator G-M-R Oil

Well No. 1 Farm Dufford "B"

Elev. \_\_\_\_\_ Location NE NW NE

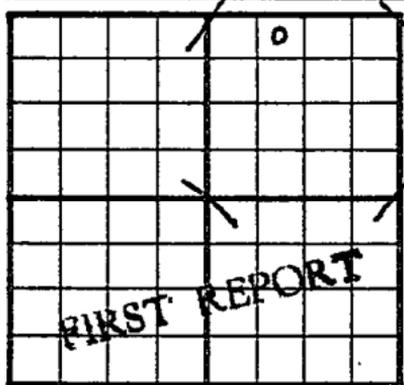

330 Ft. From N Line NE

990 Ft. From W Line Quarter

1st. Report AUG 25 1954

Completion \_\_\_\_\_

Remarks CSO farmout

G-M-R - Contr.

Spudding Date 8-18-54

Drig. Data Sweeney Pool

8" @ 946 drlg. 3062

FABEN GILSIRA

