

DX 78-1

Pawnee


KANSAS

O.W.W.G. O.W.P.B.

Section 18 Township 21 Range 15W

Well No. #2 Dufford "B"

Company G-M-R Oil

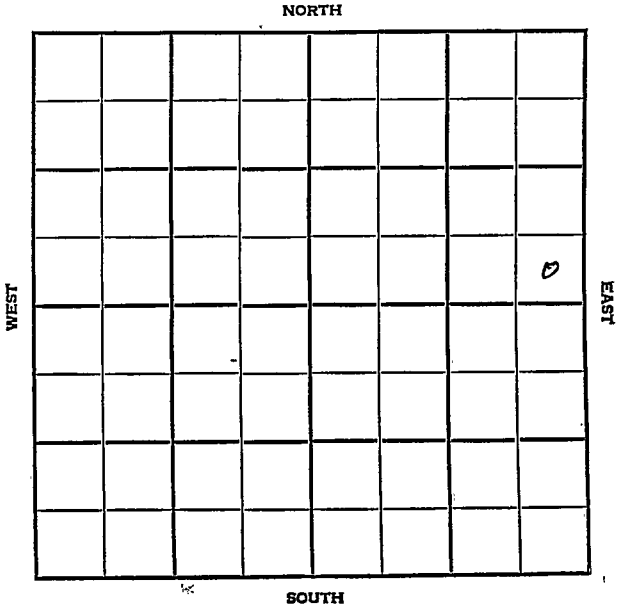

SEC. 18 TWP. 21 R. 15W

WELL NO. 2 Dufford "B" FARM

COMPANY G-M-R Oil


CONTRACTOR Co. Tools  
Sweeny Pool

Ft. from N. Line

330 Ft. from S. Line

330 Ft. from E. Line

Ft. from W. Line

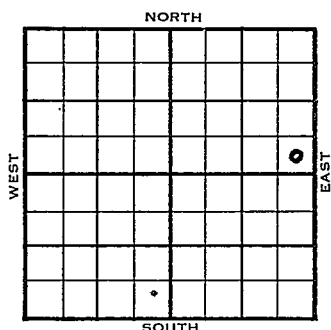

SE SE NE

| 1954 | ELEVATION 1960' | REPORT |
|------|-----------------|--------|
|------|-----------------|--------|

10/27 Spud 10-22-54  
Anhy 936'  
8" @ 946'  
Drilg. 2571'

11/10 Spud 10-22-54  
Gas Well  
TD 3840'  
Anhy 936'  
8" @ 946'  
Heeb 3316', Br. Lime 3416', Lans 3426'  
Cong 3678' Simp 3754' Arb 3795'  
TD 3840'  
5" @ 3840'  
DST 3835'-40' opn 1 hr, 1,500,000 cfg.  
60' gco 1210#  
CO to 3840'  
18/ 3826-32  
Comp 3,500,000 cfgpd.

COMPLETED

COMPLETED

1955  
1/12

O.W.W.O.

Anhy 936 Heeb 3316 Br. lime 3416  
Lans. 3426 Sooy 3678 Simp 3754  
Arb. 3795 OTD 3840 5" @ 3840  
DD 3842 S/52 BO 5 hr.

OVER

# O.W.W.O.

1955

2/9

Oil Well - TD 3843'  
Anhy 936', Heeb. 3316', Br lime 3416',  
Lans. 3426', Sooy 3678', Simp 3754',  
Arb. 3795'  
OTD 3840'  
5" @ 3840'  
DD 3842',  
S/10 bo 5 hrs.  
DD 3843'  
S/11½ bo 2% w 2 hrs.  
DD 3845  
S/8 to 10 bfph 30 to 35% wtr. 12 hrs.  
CO to 3841, S/1½ bf 34% wtr. 2 hrs.  
SP, 8/3838-40, 200A  
S/1.67 bo 10% wtr.,  
CO to 3842', S/3½ boph 3% wtr., 100A  
SI 2 hrs.  
F/23 boph 4% wtr. 5 hrs.  
3,000,000 cfg  
Comp. F/25 bopd 4% wtr., 3,000,000 cfg

**COMPLETED**

1955

4/27

## O.W.P.B.

Gas well TD 3840'  
Lans 3426' Cong 3678' Simp 3754'  
Arb. 3795' OTD 3840' 5" @ 3840  
F/23 BOPH 3,000 MCFG F/3 BO 7 BW  
CO 15/3727-33 15/3711-17 441 MCFG  
dry-frac. 250 MA  
Comp. 10,000,000 CFGPD

**FIRST REPORT**

**COMPLETED**

County Pawnee State KansasSec. 18 (Blk.) 21 (Sur.) 15W Map No.Operator G-M-R OilWell No. 2 Farm Dufford "B"Elev. Location SE SE NE

|  |  |  |  |  |  |  |  |
|--|--|--|--|--|--|--|--|
|  |  |  |  |  |  |  |  |
|  |  |  |  |  |  |  |  |
330 Ft. From S Line NE330 Ft. From E Line Quarter1st. Report OCT 27 1954

Completion

Remarks

Co. toolsSpudding Date 10-22-54Drlg. Data Sweeny PoolAnhy 936 8" @ 946 drlg. 2571

FABEN G'ILSTRAP

OCT 28 1954

Scout Cards \_\_\_\_\_

Land Small Map \_\_\_\_\_

Land Wall Map \_\_\_\_\_


Tracings \_\_\_\_\_

France Map \_\_\_\_\_

Pierce Map \_\_\_\_\_

Misc. \_\_\_\_\_

Orig. Data

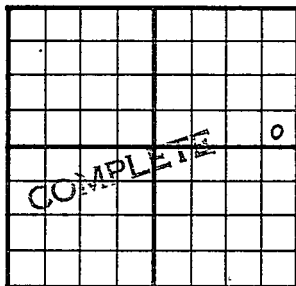County Pawnee State KansasSec. 18 (Blk.) 21 (Sur.) 15W Map No.Operator G-M-R OilWell No. 2 Farm Dufford "B"Elev. 1960 Location SE SE NE330 Ft. From S Line NE330 Ft. From E Line Quarter

1st. Report

Completion NOV 10 1954Remarks Sweeny PoolCo. toolsSpudding Date 10-22-54Drlg. Data Gas well TD 3840Anhy 936 8" @ 946 Heeb. 3316Br. lime 3416 Lans. 3426 Cong. 3678Simp. 3754 Arb. 3795 TD 3840 5" @ 3840DST 3835-40 open 1 hr. 1,500,000 cfg60' geo 1210# CO to 3840 18/ 3826-32Comp. 3,500,000 cfcpd

FABEN GILSTRAP

May 16 1934

|                |       |
|----------------|-------|
| Scout Carls    | ..... |
| Land Small Map | ..... |
| Land Wall Map  | ..... |
| Tracings       | ..... |
| Financial      | ..... |
| Physical Map   | ..... |
| Map            | ..... |

Orig. Date

O.W.W.O.

County Pawnee State KansasSec. 18 (Blk. Twp.) 21 (Sur. Rge.) 15W Map No.Operator G-M-R OilWell No. 2 Farm Dufford "B"Elev. 1960 Location SE SE NE

|  |  |  |  |  |  |  |  |
|--|--|--|--|--|--|--|--|
|  |  |  |  |  |  |  |  |
|  |  |  |  |  |  |  |  |
330 Ft. From S Line NE330 Ft. From E Line Quarter1st. Report JAN 1 2 1955

Completion

Remarks OWNO

O.W.W.O.

Spudding Date

Drlg. Data Sweeney PoolAnhy 936 Heeb. 3316 Br. lime 3416Lans. 3426 Sooy 3678 Simp. 3754Arb. 3795 OTD 3840 5" @ 3840DD 3842 S/ 52 bo 5 hr.

FAREN GILSTAD



JAN 14 1955

|                |           |
|----------------|-----------|
| Scout Cards    | <i>mm</i> |
| Land Small Map |           |
| Land Wall Map  |           |
| Tracings       | <i>B</i>  |
| France Map     |           |
| France Map     |           |
| Minor          |           |

Drig. Data

O.W.W.O.


County Pawnee State Kansas

Sec. 18 (Blk.) 21 (Sur. Rge.) 15W Map No.

Operator G-M-R Oil

Well No. 2 Farm Dufford "B"

Elev. 1960 Location SE SE NE

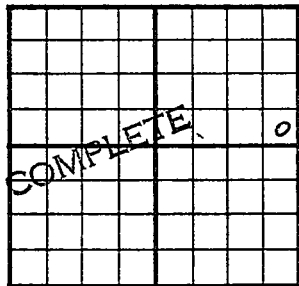

330 Ft. From S Line NE

330 Ft. From E Line Quarter

1st. Report

Completion FEB 9 1955

Remarks OWWO

Spudding Date

Drlg. Data Oil well TD 3843

Anhy 936 Heeb. 3316 Br. lime 3416

Lans. 3426 Sooy 3678 Simp. 3754

Arb. 3795 OTD 3840 5" @ 3840 DD 3842

S/ 10 bo 5 hr. DD 3843 S/ 11½ bo 2% w

2 hr. DD 3845 S/ 8 to 10 bfph 30 to

35% wtr. 12 hr. CO to 3841 S/ 1½ bf

34% wtr. 2 hr. SP 8/ 3838-40

200 A S/ 1.67 bo 10% wtr. CO to 3842

S/ 3½ boph 3% wtr. 100 A SI 2 hr.

F/ 23 boph 4% wtr. 5 hr. 3,000,000 cfg

Comp. F/ 25 bopd 4% wtr. 3,000,000 cfg

FABEN GILSTRAP

FEB 15 1955

15 1955

Drig. Date

Misc.

3

FABEN GILSTRAP

MAY 2 1955

|                |           |
|----------------|-----------|
| Scout Cards    | <i>MM</i> |
| Land Small Map | .....     |
| Land Wall Map  | .....     |
| Tracings       | .....     |
| Exposure Map   | .....     |
| Pierce Map     | .....     |
| Misc.          | .....     |

Orig. Data