


Section 18 Township 21 Range 15WWell No. #1 GivensCompany G-M-R Oil

NORTH

WEST

EAST

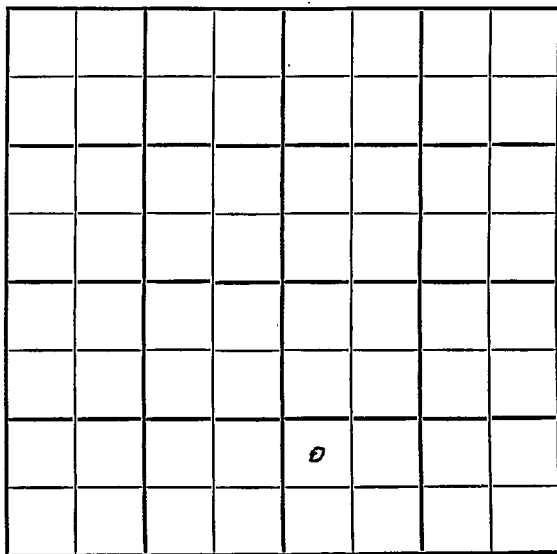

SOUTH

Pawnee

KANSAS

|            |      |       |
|------------|------|-------|
| SEC.       | TWP. | R.    |
| 18         | 21   | 15W ✓ |
| WELL NO.   |      |       |
| #1 Givens  |      |       |
| FARM       |      |       |
| COMPANY    |      |       |
| G-M-R Oil  |      |       |
| CONTRACTOR |      |       |


Wildcat.

Ft. from N. Line

990 Ft. from S. Line

Ft. from E. Line

330 Ft. from W. Line

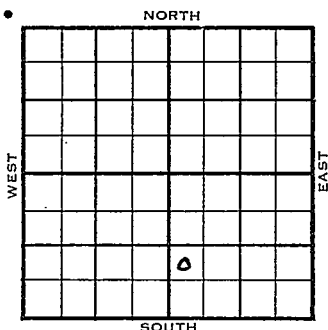


NW SW SE

|      | ELEVATION                             | REPORT |
|------|---------------------------------------|--------|
| 1954 | 1965'                                 |        |
| 4/27 | M I R                                 |        |
| 5/5  | Anhy 935'                             |        |
|      | 8" @ 946' w/400 sks                   |        |
|      | rlg. 2911'                            |        |
| 5/12 | Spud 4-29-54                          |        |
|      | D&A                                   |        |
|      | TD 3965'                              |        |
|      | Anhy 935'                             |        |
|      | 8" @ 946'                             |        |
|      | Br lime 3441', Lans 3451'             |        |
|      | DST 3444-81', opn 1 hr., rec. 22' mud |        |
|      | O#                                    |        |
|      | Cong 3751'                            |        |
|      | DST 3825-64', opn 1 hr., rec. 33' mud |        |
|      | O#                                    |        |
|      | Arb. 3934'                            |        |
|      | TD 3965'                              |        |
|      | D&A                                   |        |

ABANDONED

J. G. McGEHEE

County Pawnee State Kansas  
 Sec. 18 (Blk. Twp.) 21 (Sur. Rge.) 15W Map No. \_\_\_\_\_  
 Operator G-M-R Oil  
 Well No. 1 Farm Givens  
 Elev. 1965 Location NW SW SE

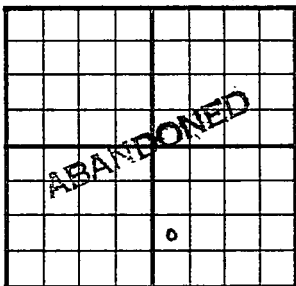

990 Ft. From S Line SE  
330 Ft. From W Line Quarter  
 Ist. Report \_\_\_\_\_  
 Completion MAY 12 1954  
 Remarks Wildcat

Spudding Date 4-29-54  
 Drlg. Data D & A TD 3965

Anhy 935 8" @ 946 Br. lime 3441

Lans. 3451 DST 3444-81 open 1 hr.

Rec. 22' mud 0# Cong. 3751

DST 3825-64. open 1 hr. Rec. 33' mud

0# Arb. 3934 TD 3965

D & A

J. G. McGEHEE