

O.W.W.O.

Pawnee

DX 78-1

KANSAS

Section 18 Township 21 Range 15W

Well No. #2 Givens

Company G.M.R.

NORTH

WEST

							0

EAST

SOUTH

O W W O

Pawnee

KANSAS

SEC.	TWP.	R.
18	21	15 W
WELL NO.		
# 2 Givens		
COMPANY		FARM
G_M_R		
CONTRACTOR		
Sweeney		


330 Ft. from N. Line

Ft. from S. Line

330 Ft. from E. Line

Ft. from W. Line

NE NE SE

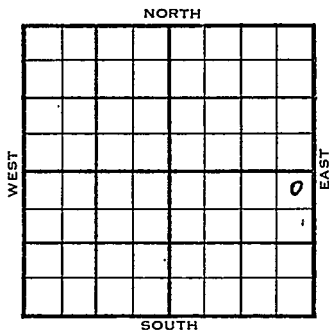

1961' RB

1961' DF

REPORT

1954

9/15

Spud 9-10-54

8" @ 946

Drlg. 1942'

11/23

Spud 9-10-54 - Oil Well

TD 3860'

8" @ 946'

Heeb 3216', Br. lime 3416', Lans 3426'

TD 3860'

Arb. 3800'

5" @ 3860'

CO, 23/3838-43,

F/12 boph 3,000,000 cfg

F/8 boph

F/6.68 boph

Comp. 25 bopd

3,000,000 cfgpd

COMPLETED

O.W.W.O.

1955

6/22

5" @ 3860 CO. Sq perf 3838-43 w/75

WOC.

L. 3426' A. 3800' TD 3860'

COMPLETED

6/29


5" @ 3860 Co perf/3838-43 CO to
3860 11/3828-32 11/3822-25 SSG 500A
7,110 mcfg Comp shut in gas well

FABEN GILSTRAP

Scout Cards	mm
Land Small Map	
Land Wall Map	
Tracings	
France Map	
Pierce Map	
Misc	

SEP 17 1954

Drig. Data

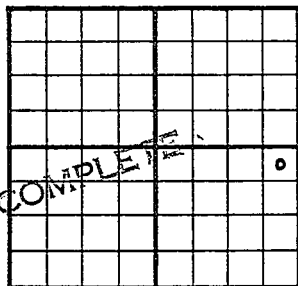County Pawnee State KansasSec. 18 (Blk. 21) (Sur. 15W) Map No.Operator G-M-R OilWell No. 2 Farm GivensElev. 1961 Location NE NE SE330 Ft. From N Line SE330 Ft. From E Line Quarter

1st. Report

Completion NOV 23 1954

Remarks

Spudding Date 9-10-54Drilg. Data Oil well TD 38608" @ 946 Heeb. 3216 Br. lime 3416Lans. 3426 TD 3860 Arb. 3800 5" @ 3860CO 23/ 3838-43 F/ 12 boph 3,000,000 cfbF/ 8 boph F/ 6.68 boph Comp. 25 bopd3,000,000 cfbpd

FABER GILST

NOV 30 1954

Secret Cards	_____
Long Street Map	_____
Long Wall Map	_____
Traffic	_____
France Map	_____
Pierce Map	_____
Misc.	_____

Orig. Data

O.W.W.O.

FORM 513 REV. SUNRAY

OWWO

County Pawnee Elev. 1964 RB
1961 DF
 Sec. 18 Twp. 21 Rge. 15W
 Company G-K-R Oil
 Farm Name Givens No. 2

TOPS	DEPTH	LOG	DATUM
Anh.	-		
TP.	-		
H.	-		
Tr.	-		
Dg.	-		
BL.	-		
L.	<u>3426</u>		
K.C.	-		
B.K.C.	-		
Ce.	-		
C.	-		
M.	-		
M.	-		
K.	-		
Mz.	-		
Mq.	-		
V.	-		
S.	-		
S.	-		
A	<u>3800</u>		
R.	-		
PE.	-		
G.	-		
	-		
T.D.	<u>3860</u>		

Loc. in Sec. NE NE SEGeol. SweeneyContr. SweeneyPool Sweeney

Sweeney

FIRST REPORT
JUN 22 '55

Date Comm. 5" @ 3860

CO sq. perf 3838-43/75 EOC

JUN 27 1955

Scout Cards	<i>mm</i>
Land Small Map	
Land Wall Map	
Tracings	
France Map	
Pierce Map	
Misc.	

OWWO

1964 RB
1961 DF

County Pawnee

Elev.

Sec. 18

Twp. 21

Rge. 15W

Company G-M-R Oil

Farm Name Givens

No. 2

TOPS

DEPTH

LOG

DATUM

Loc. in Sec.

Anb.

T.P.

H.

Tr.

Dg.

BL.

L.

K.C.

B.K.C.

Ce.

C.

M.

M.

K.

Mz.

Me.

V.

S.

S.

A

R.

P.E.

G.

T.D.

3426

1465

Geol.

Contr.

Pool

Sweeney

3800

1839

COMPLETE

3860

JUN 29 1955

Date Comm.

5" @ 3860 CO perf/ 3838-43

CO to 3860 11/ 3828-32 11/ 3822-25

SSG 500 A 7,110 mcfg

Comp. shut in gas well

Scout Cards J.C.
Land Small Map
Land Wall Map
Tracings
France Map
Pierce Map
Misc.

JUL 8 1955