


Section 18 Township 21 Range 15W

Well No. #1 Unruh

Company G-M-R Oil

NORTH

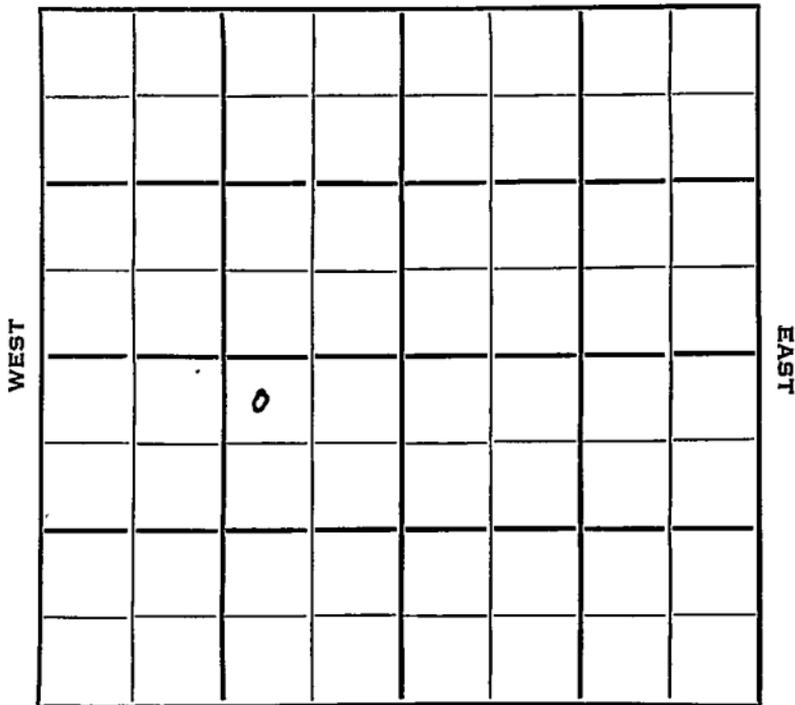

SOUTH

Pawnee KANSAS

SEC.	TWP.	R.
18	21	15W

WELL NO. **1 Unruh** FARM

COMPANY **G-M-R Oil**

CONTRACTOR **G-M-R**


**Semi Wildcat**

**330** Ft. from N. Line

\_\_\_\_\_ Ft. from S. Line

**990** Ft. from E. Line

\_\_\_\_\_ Ft. from W. Line

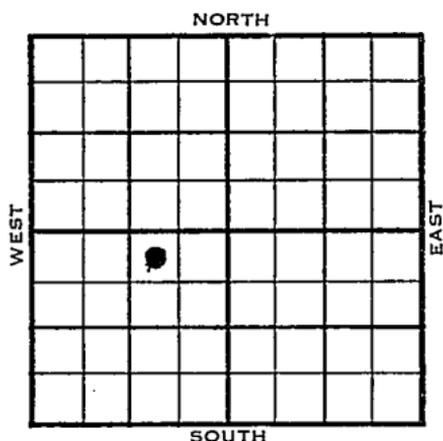

NW NE SW  
CSO Farmout

1954	ELEVATION 1963'	REPORT
------	--------------------	--------

4/14 Spud 4-12-54  
8" @ 947'  
Anhy 932'

5/5 Heeb 3328'; Br li 3427', Lans 3437',  
Cong 3718', Arb. 3801'  
DST 3815-30', 1 hr., gauge 3 1/2 M gas,  
1240#  
DST 3835-50', 1/2 hrs., 3.8 M gas,  
F oil 1/2 hrs., 330' free oil, 1300#  
RTD 3850'  
5" @ 3850'

7/21 Spud 4-12-54 Gas well TD 3850  
8" @ 947' Anhy 932' Heeb 3328  
Br. lime 3427' Lans 3437' Cong 3718  
Arb. 3801  
DST 3815-30 open 1 hr, 3 1/2 MCFG 1240#  
DST 3835-50 open 1/2 hr 3.8 MCFG.  
F/oil in 1/2 hr. 330' free oil 1300#  
TD 3850 5" @ 3850 CO to 3850  
4 BWPB CO to 3842 30/3844-49  
6.4 MCFG F/3 1/2 BOPB 500 A  
Comp. 6 1/2 MCFGPD 4 BOPB

**COMPLETED**

County **Pawnee** State **Kansas**

Sec. **18** (Blk. Twp.) **21** (Sur. Rge.) **15W** Map No.

Operator **G-M-R Oil**

Well No. **1** Farm **Unruh**

Elev. Location **NW NE SW**

<b>FIRST REPORT</b>					

**330** Ft. From **N** Line **SW**

**990** Ft. From **E** Line **Quarter**

1st. Report **APR 14 1954**

Completion

Remarks **GSO farmout**

**G-M-R - Contr.**

Spudding Date **4-12-54**

Drilg. Data **SemiWildcat**

**8" @ 947 Anhy 932**

