

Section 18 Township 21 Range 11W

Well No. #1 Bright

Company Sohio

Sandigo Pool

NORTH

		0					

WEST

EAST

SOUTH

Sec. 18 Twp. 21 R. 11W

Well No. #1 Bright Farm
Sohio Company


Sandigo Pool

330 Ft. from N. Line

_____ Ft. from S. Line

990 Ft. from E. Line

_____ Ft. from W. Line
NW NE NW

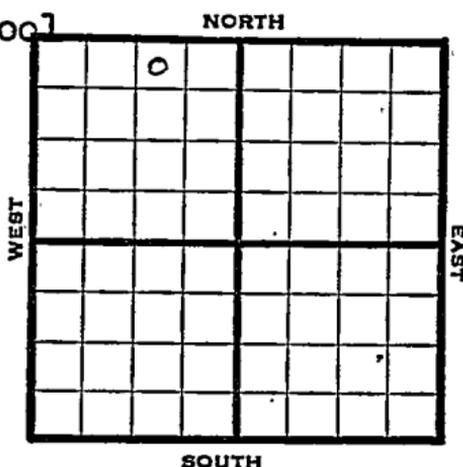

1947

Elev. 1814' REPORT

10/29

Location

11/5

Drlg. 600'

11/12

Drlg. 2850'

11/19

Lansing 3185'
Arbuckle 3488'
TD 3499'

11/25

TD 3500'
5" @ 3490'
2000 acid.

12/3

Swb. 1 1/4 bbls. oil 1/2 1/2 W PH 7 hrs.

12/10

"

12/23

Arb. 3488'
5" @ 3490' 2000 acid
Pump 36 oil 1/4 15% W pot
Gr. 38.0
TD 3500'

COMPLETED

Map No. _____ Sec. 18 Twp. 21 R. 11W

Well No. 1 Bright

Sohio Company

FIRST REPORT Contractor

NW NE NW


SECTION PLAT

330 Ft. from N. Line

_____ Ft. from S. Line

990 Ft. from E. Line

_____ Ft. from W. Line

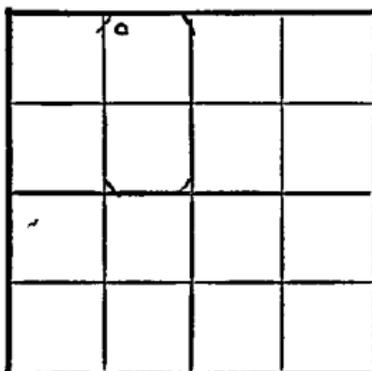

Stafford County

Location X

Rig up _____

Drilling and Remarks:

RECORD

Cased _____ in., _____ ft.

Sand _____

Gas _____

Oil _____

Total Depth _____

PRODUCTION

1st 24 hrs. Nat. _____

1st 24 hrs. after shot _____

Gas _____ Cu. Ft.

Dry Hole _____

Abandoned _____

Date

OCT 29 1947 19

S. J. LEWIS Scout

Map No. 46 Sec. 18 Twp. 21 R. 11W

Well No. 1 Bright

Sohio Company

COMPLETE

Contractor

NW NE NW

E.H. 1874
SECTION PLAT

330 Ft. from N. Line

	0		

_____ Ft. from S. Line

990 Ft. from E. Line

_____ Ft. from W. Line

Stafford County

Location _____

RECORD

Rig up _____

Cased _____ in., _____ ft.

Drilling and Remarks:

Sand _____

Gas _____

Oil _____

Total Depth 3500

=====

283488
5" (23490)
2000 acid
Pump 86 oil 410%
W.B.T.
3500

PRODUCTION

1st 24 hrs. Nat. _____

1st 24 hrs. after shot _____

Gas _____ Cu. Ft.

Dry Hole _____

Abandoned _____

Date

DEC 23 1947 19

S. J. LEWIS Scout