


Section 18 Township 21 Range ~~12W~~ 11W
Well No. 1 Keeler
Company Deep Rock

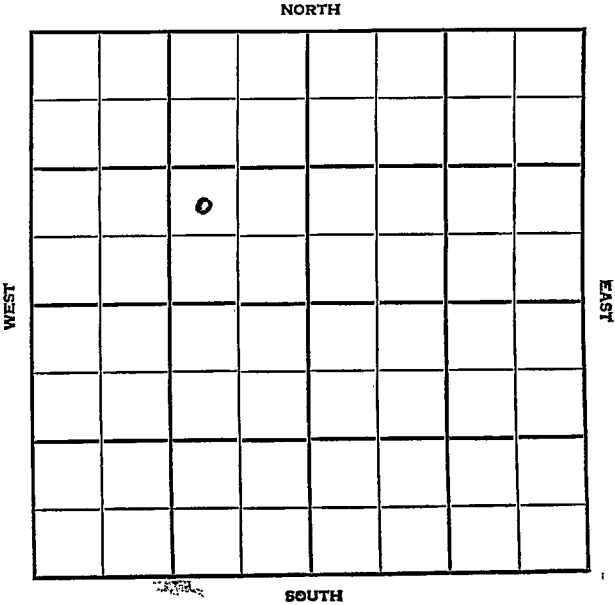

Stafford KANSAS

SEC.	TWP.	R.
18	21	11W 19W

WELL NO.

1 Keeler

FARM

COMPANY

Deep Rock

CONTRACTOR

Musgrove


Semi Wildcat

Ft. from N. Line

990 Ft. from S. Line

990 Ft. from E. Line

Ft. from W. Line

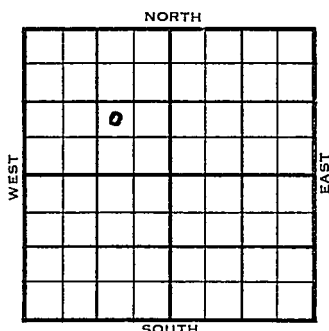

NW SE NW

Phillips Farmout

	ELEVATION	REPORT
1954 ±	1819'	

8/11

MIR

8/25

Spud 8-10-54 D & A TD 3535
 10" @ 329 Heeb 3040 Br. lime 3167
 Lans. 3183' DST 3209-57, open 35 min
 rec 120' VSOCMS 315#
 DST 3257-87 open 1/2 hr rec 10' VSOCM
 410# DST 3355-90 open 1/2 hr rec 30'
 VSOCM 0# Cong. 3429 Simp 3445
 Arb. 3496
 DST 3497-3502 open 1/2 hr rec 20' mud
 940# DST 3501-07 open 1/2 hr rec
 10' mud. 1150#
 DST 3507-13 open 1 hr rec 170' mud
 120' SW 1050#
 DST 3426-98, open 45 min rec 140' mud
 0#. TD 3535
 Schl tops: Heeb 3041 Br lime 3167
 Lans 3186 Cong 3428 Simp 3440
 Simp. sd 3460. Arb. 3497'
 D & A

ABANDONED

State **11W**
19W

FIRST REPORT

Spudding Date _____

72

Kansas

Map No. _____ Sec. 18 Twp. 21 R. 11WWell No. 1 Keeler

Deep Rock

Company

CORRECTION

Contractor

NW SE NW

SECTION PLAT

	o		

_____ Ft. from N. Line

990 Ft. from S. Line990 Ft. from E. Line

_____ Ft. from W. Line

Stafford County

Location _____

Rig up _____

Drilling and Remarks:

Reported
18-21-19W

RECORD

Cased _____ in., _____ ft.

Sand _____

Gas _____

Oil _____

Total Depth _____

PRODUCTION

1st 24 hrs. Nat. _____

1st 24 hrs. after shot _____

Gas _____ Cu. Ft.

Dry Hole _____

Abandoned _____

Date

AUG 18 1954 19

FABEN GILSTRAP Scout


County Stafford State Kansas

Sec. 18 (Blk.) 21 (Sur.) 11W Map No.

Operator Deep Rock

Well No. 1 Farm Keeler

Elev. 1819 Location NW SE NW

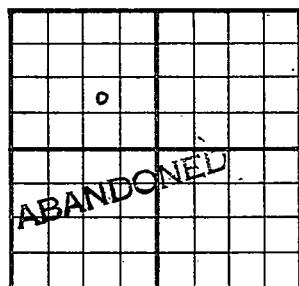

990Ft. From S Line NW

990Ft. From E Line Quarter

1st. Report

Completion AUG 25 1954

Remarks Semi Wildcat

Musgrove - Contr.

Spudding Date 8-10-54

Drig. Data D & A TD 3535

10" @ 329 Heeb. 3040 Br. lime 3167

Lans. 3183 DST 3209-57 open 35 min.

Rec. 120' vsocsm 315# DST 3257-87

open 1/2 hr. Rec. 10' vsocm 410#

DST 3355-90 open 1/2 hr. Rec. 30' vsocm

0# Cong. 3429 Simp. 3445 Arb. 3496

DST 3497-3502 open 1/2 hr. Rec. 20' mud

940# DST 3501-07 open 1/2 hr. Rec.

10' mud 1150# DST 3507-13 open 1 hr.

Rec. 170' mud 120' sw 1050# DST 3426-

98 open 45 min. Rec. 140' mud 0#

TD 3535 SCHLUMBERGER TOPS:

Heeb. 3041 Br. lime 3167 Lans. 3186

Cong. 3428 Simp. 3440 Simp. sd. 3460

Arb. 3497

D & A

FABEN GILSTRAP