

KANSAS

Stafford

FORM 51 IOM 12-46 PETROL


Section 18 Township 21 Range 11-W

Well No. 1 Klein

Company Phillips

Sandago Pool

NORTH

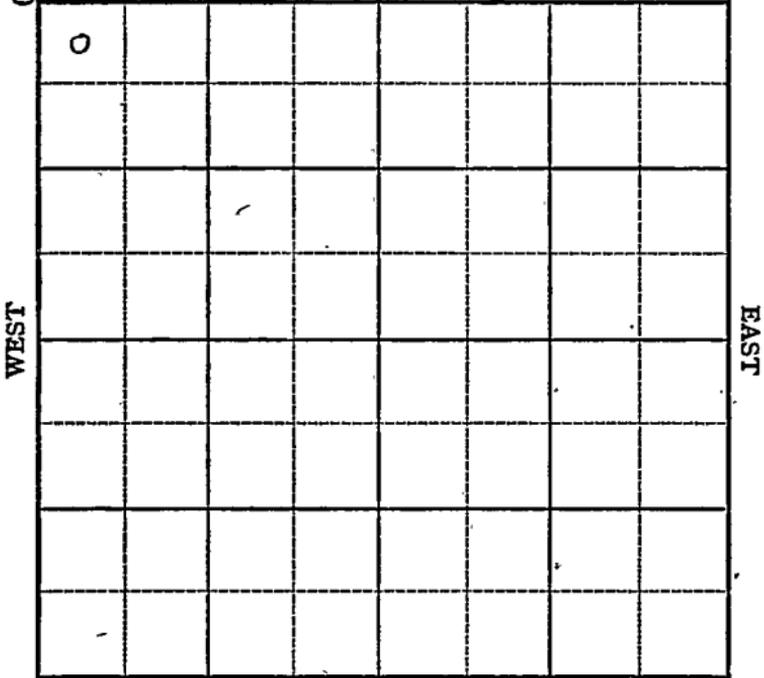

SOUTH

KANSAS

Stafford

Sec. 18 Twp. 21 R. 11-W

Well No. 1 Klein Farm  
Phillips Company


Sandago Pool  
330 Ft. from N. Line

\_\_\_\_\_ Ft. from S. Line

\_\_\_\_\_ Ft. from E. Line

330 Ft. from W. Line

NW/C

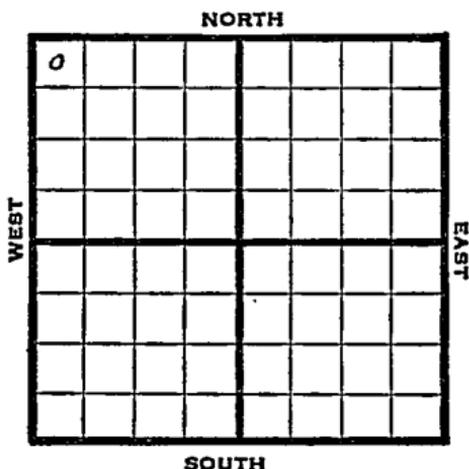

1947	Elv. 1815'	REPORT
8/13	Loc.	
8/20	8" @ 615'	WOO
8/27	Lansing 3174'	Drig. 3353'
9/3	Arbuckle 3477	TD 3485'
	5" @ 3478 $\frac{1}{2}$ '	RUST
9/10	"	
9/17	"	
9/24	2000 acid	Pump 24 bbls. oil / 5W 6 hrs.
10/1	"	
10/8	PB 3432-52 shots 3897-3410	1500 acid swb 164 bbls oil in 9hrs.
10/15	"	
10/22	"	
11/5	Lans. 3174'	Arbuckle 3477'
	5" @ 3478 $\frac{1}{2}$ '	Perf Lans.
	1500 Acid	Pump 627 Pot

OVER

(continued)

1947

11/5

Gr. 39°

Total Depth 3485'

**COMPLETED**

Map No. \_\_\_\_\_ Sec. 18 Twp. 21 R. 11W

Well No. 1 Klein

Phillips Company

FIRST REPORT Contractor

NW/C

SECTION PLAT

330 Ft. from N. Line

\_\_\_\_\_ Ft. from S. Line

\_\_\_\_\_ Ft. from E. Line

330 Ft. from W. Line

o			

Stafford County

Location X

Rig up \_\_\_\_\_

Drilling and Remarks:

RECORD

Cased \_\_\_\_\_ in., \_\_\_\_\_ ft.

Sand \_\_\_\_\_

Gas \_\_\_\_\_

Oil \_\_\_\_\_

Total Depth \_\_\_\_\_

PRODUCTION

1st 24 hrs. Nat. \_\_\_\_\_

1st 24 hrs. after shot \_\_\_\_\_

Gas \_\_\_\_\_ Cu. Ft.

Dry Hole \_\_\_\_\_

Abandoned \_\_\_\_\_

Date

AUG 13 1947 19

S. J. LEWIS Scout

Map No. 46 Sec. 18 Twp. 21 R. 11W

Well No. 1 Klein

Phillips Company

**COMPLETE** Contractor

NW/C

*E 11/875*  
SECTION PLAT

330 Ft. from N. Line

\_\_\_\_\_ Ft. from S. Line

\_\_\_\_\_ Ft. from E. Line

330 Ft. from W. Line

0			

Stafford County

Location \_\_\_\_\_

Rig up \_\_\_\_\_

Drilling and Remarks:

*Lease 3174*

*CR 3477*

*5103478 1/2*

*Per Kansas  
1800 acres*

*Pump 627 BY  
29 2/2*

**RECORD**

Cased \_\_\_\_\_ in., \_\_\_\_\_ ft.

Sand \_\_\_\_\_

Gas \_\_\_\_\_

Oil \_\_\_\_\_

Total Depth *3475*

**PRODUCTION**

1st 24 hrs. Nat. \_\_\_\_\_

1st 24 hrs. after shot \_\_\_\_\_

Gas \_\_\_\_\_ Cu. Ft.

Dry Hole \_\_\_\_\_

Abandoned \_\_\_\_\_

Date

NOV 5 1947 19

S. J. LEWIS Scout