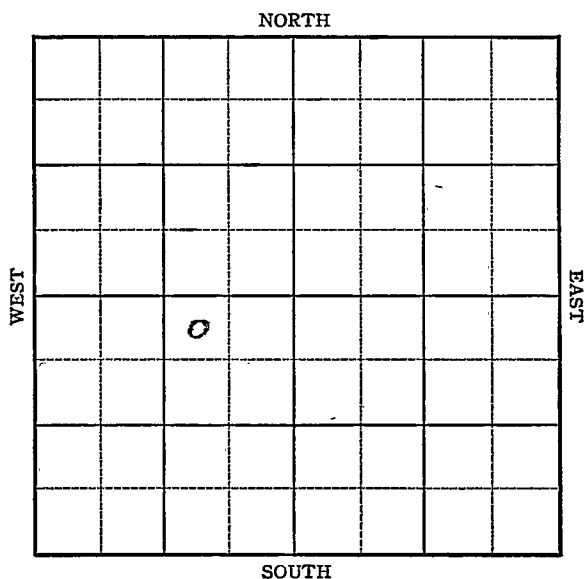


KANSAS

Stafford

Section 18 Township 21 Range 11WWell No. #1 RaderCompany Sohio

Sec. 18 Twp. 21 R. 11WWell No. #1 Kader Farm

Sohio

Company

Snider

330

Ft. from N. Line


Ft. from S. Line

990

Ft. from E. Line

Ft. from W. Line

NW NE SW

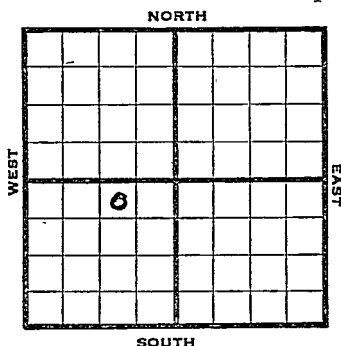

1945

R E P O R T

2/28

. Location

3/7

"

3/14

R U R

3/23

8" @ 323

Anhy 600

Drlg. 1473

3/29

Drlg. 2896

4/4

Topeka 2784

Lans 3215

BKC 3470

Socy 3477

Simp 3541

Arb 3561

TD 3600

ABANDONED


Pool Name SniderMap No. 46 Sec. 18 Twp. 21 R. 11WWell No. 1 KaderSohio Company

FIRST REPORT

Contractor

NW NE SW

SECTION PLAT

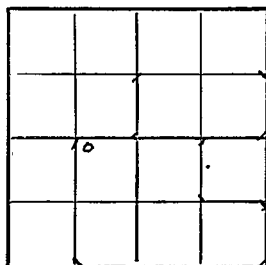330 Ft. from N. Line Ft. from S. Line990 Ft. from E. Line Ft. from W. LineStaffordLocation XRig up

Drilling and Remarks:

RECORD

Cased in., ft.Sand Gas Oil Total Depth

PRODUCTION

1st 24 hrs. Nat. 1st 24 hrs. after shot Gas Cu. Ft.Dry Hole Abandoned

Date

FEB 28 1945 19S. J. LEWIS

Scout

Pool Name SniderMap No. K46 Sec. 18 Twp. 21 R. 11WWell No. 1 RaderSohio

Company

ABANDONED


Contractor

NV NE SW

SECTION PLAT

330 Ft. from N. Line Ft. from S. Line990 Ft. from E. Line Ft. from W. Line

Stafford County

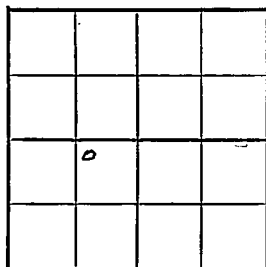

Location _____

Rig up _____

Drilling and Remarks:

*Top of 2754**Trans 3215**BTC 3470**Boop 3477**Boop 3541**Boop 3521*

RECORD

Cased _____ in., _____ ft.

Sand _____

Gas _____

Oil _____

Total Depth 3600

PRODUCTION

1st 24 hrs. Nat. _____

1st 24 hrs. after shot _____

Gas _____ Cu. Ft.

Dry Hole _____

Abandoned _____

Date

APR 4 1945 19S. J. LEWIS Scout