

Section 18 Township 21 Range 16 WWell No. # 1 HewsonCompany Murphy Oil

			0				

NORTH

WEST

EAST

SOUTH

Pawnee

KANSAS

SEC.	TWP.	R.
18.	21	16W ✓

WELL NO.

1 Hewson

FARM

COMPANY

Murphy Oil

CONTRACTOR

Barbour Drlg.


Wildcat

330 Ft. from N. Line

Ft. from S. Line

330 Ft. from E. Line

Ft. from W. Line

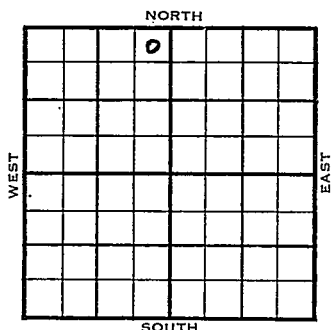

NE NE NW

Gulf - \$3000 DHM

	ELEVATION	REPORT
1953	2010'	

10/21 Spud 10-13-53
8" @ 997'
Anhy 991'
Drlg. 3035'

10/28 Spud 10-13-53 D & A TD 3933'
8" @ 997 Anhy 991' Heeb 3412'
Tor. 3432' Br. line 3503' Lans 3505'
Cong. 3829' Arb. 3901' TD 3933'
D & A

ABANDONED.

County Pawnee State Kansas
 Sec. 18 (Blk. 21 (Sur. 16W Map No.
 (Twp.) (Rge.)
 Operator Murphy Oil
 Well No. 1 Farm Hewson
 Elev. Location NE NE NW

FIRST REPORT

330 Ft. From N Line NW
330 Ft. From E Line Quarter
 Ist. Report OCT 21 1953
 Completion
 Remarks Gulf - \$3000 DHM
Barbour Drlg. - Contr.
 Spudding Date 10-13-53

Drlg. Data Wildcat
8" @ 997 Anhy 991 drlg. 3035

J. G. McGEHEE

County Pawnee State KansasSec. 18 (Blk.
Twp.) 21 (Sur.
Rge.) 16W Map No.Operator Murphy OilWell No. 1 Farm HewsonElev. 2010 Location NE NE NW

		0			

330 Ft. From N Line NW330 Ft. From E Line Quarter

1st. Report

Completion OCT 28 1957Remarks WildcatBarbour - Contr.Spudding Date 10-13-53Drilg. Data D & A TD 39338" @ 997 Anhy 991 Heeb. 3412Tor. 3432 Br. lime 3503 Lans. 3505Cong. 3829 Arb. 3901 TD 3933D & A