

KANSAS


FORM 51 5M 11-44 PETROL

Stafford County

Section 19 Township 21S Range 12W


Well No. #2 Karl Fischer

Company Mid-Cont. Petr. Corp.

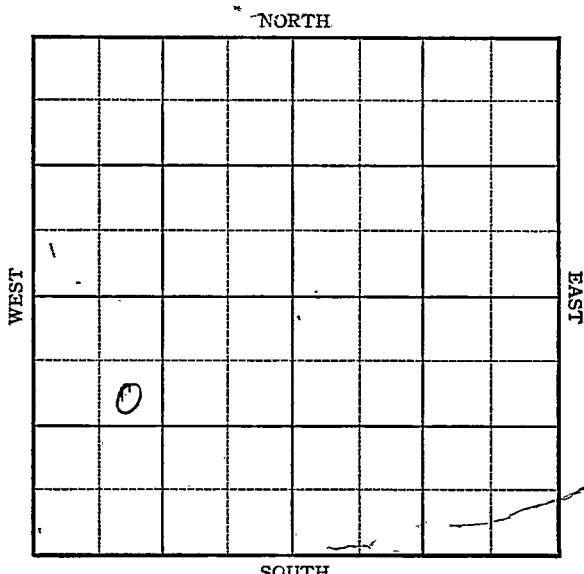

Sec. 19 Twp. 21 R. 12WWell No. #2 Karl Fischer FarmMid-Continent Petr. Corp. Company

Mueller

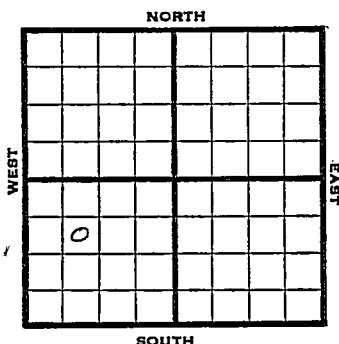990 Ft. from N. Line Ft. from S. Line~~990~~ Ft. from E. Line990 Ft. from W. Line

SE NW SW

1946 Elev. 1866' REPORT

6/5	Location	
6/6	Making road. Cleaning location site.	
6/7	Moving in tools.	(Tel) (P.R)
6/10	Spudded 6-8-46 9-5/8" set 298' T.D. 305'	(P.R)
6/11	Drilling 1120'	"
6/13	Drilling 1930'	"
6/14	Drilling 2130'	"
6/17	Drilling 2690'	"
6/18	Drilling 2855'	"
6/19	Drilling 2995'	"
6/20	Drilling 3110'	"
6/21	Came out of lime 2990' Drilling 3252' shale.	"
6/22	Drilling 3295' no shows. Running low.	(Telegram)
6/25	Viola 3518' Simpson shale 3540' Simpson sand 3580' Total Depth 3590' To core.	(Telegram)

VIOLA 3518'

Running 19' lower on Viola than #1 Fischer.
(Wagner)

OVER

1946 #2 Fischer MCPC ✓

6/26 Top Arbuckle 3589'
Total Depth 3611'
Will run Schlumberger. (Telegram)

TOP ARBUCKLE 3589'

Running 13' lower on top Arbuckle than
Our #1 Fischer. (Wagner)

6/26 Cored 3590'-96' show oil.
Running Schl. (PR)

6/27 5" csg. set 3606' w/300 sacks
Waiting on cement. "

7/2 Perf. 12 shots 3591'-95'
2 shots 3595'-96'
12 shots 3596'-3600'
12 shots 3600'-3604'
500 Acid thru casing
Swabbed 4-3/4" bbls. oil per hour.
(Tel)

7/8 Potential- 222 bbls. oil in 24 hrs.
6% salt water. (Tel)

7/10 Arb. 3589
5" @ 3607
TD 3611
1500 acid.
Pump 222 oil plus 6% wtr. Bot.
Grav. 41.0

COMPLETED

Kansas Pool Name Mueller

Map No. 117 Sec. 19 Twp. 21 R. 12W

Well No. 2 Karl Fischer

Mid-Continent Petroleum Corp. Company

FIRST REPORT Contractor

SE NW SW

SECTION PLAT

990 Ft. from N. Line

_____ Ft. from S. Line

~~225~~ Ft. from E. Line

990 Ft. from W. Line

Stafford County

Location X

Rig up _____

Drilling and Remarks:

RECORD

Cased _____ in, _____ ft.

Sand _____

Gas _____

Oil _____

Total Depth _____

PRODUCTION

1st 24 hrs. Nat. _____

1st 24 hrs. after shot _____

Gas _____ Cu. Ft.

Dry Hole _____

Abandoned _____

Date

JUN 5 1946 19

Scout

Chester 11 1700

Misc. Small Maps

Cards

Tracing

France Map

Scarborough Map

Pierce Map

Geological Dept.

Pierce Plat Book

KANSAS Kansas Pool Name Mueller PoolMap No. 46 Sec. 19 Twp. 21 R. 12WWell No. 2. Karl FischerMid-Continent Pet. Corp. Company**COMPLETED**

Contractor

SE NW SW

E. 1966

SECTION PLAT

990 Ft. from N. Line Ft. from S. Line990 Ft. from E. Line Ft. from W. LineStafford CountyLocation Rig up

Drilling and Remarks:

Cr 435895' @ 36071500 acidPump 222 oil + 6% WBYH. L. G.**RECORD**Cased in., ft.Sand Gas Oil Total Depth 3611**PRODUCTION**1st 24 hrs. Nat. 1st 24 hrs. after shot Gas Cu. Ft.Dry Hole Abandoned

Date

JUL 10 1946 19S. J. LEWIS

Scout

Misc. Small Maps OK
Cards Jersey
Tracing mp
France Map ✓
Scarborough Map ✓
Pierce Map mp
Geological Dept. _____
Pierce Nat. Park _____