

DRILLING WELL COMPLETION REPORT

Well No. 3 Farm Name Karl Fischer

Date completed Nov. 17, 1948

Description SW/4 Sec. 19-21S-12W

County Stafford, State Kansas

Initial production 91 bbls. Total depth 3608 feet

Initial volume _____ cu. ft. _____ lbs. rock pressure

Pipe Line Company _____

Gas Company _____

Remarks: N. E. P. E. 100%

~~Mr. Leo Meyer~~

W

Mr. Koontz
~~Mr. Koontz~~ ~~Mellor~~ ~~II~~
Accounting Dept.
Scouting Dept.
Geological Dept.
Pipe Line Dept.
Materials Dept.
Rental Dept.
Legal Dept.
Mr. Leo Meyer
Engineering Dept.
Lease Inventory
Mr. Leo Austin
File

Mid-Continent Petroleum Corporation
 Karl Fischer Well #3
 C NE SW Section 19-21-12W
 Stafford County, Kansas

Casing
 8-5/8" 308 w/325 sacks
 5-1/2" 3619 w/125 sacks

Commenced: 9-30-48
 Completed: 11-17-48
 Initial Production: 9 / b.p.d.

FORMATION


	<u>Top</u>	<u>Bottom</u>	
Clay	0	17	
Sand	17	47	
Clay & sand	47	233	
Red bed & shells	233	270	
Red bed	270	308	
Red Bed & shells	308	695	
Lime Anhydrite	695	715	
Red bed, shale & shells	715	1345	
Salt, shale & shells	1345	1475	
Shale & shells	1475	1550	
Broken lime	1550	1640	
Lime & shale	1640	1690	
Shale & shells	1690	1715	
Broken lime	1715	1745	
Sandy shale	1745	1825	
Sandy lime	1825	1870	
Shale & lime	1870	1970	
Lime	1970	1995	
Shale & lime	1995	2005	
Broken lime	2005	2065	
Shale & shells	2065	2185	
Lime	2185	2230	
Lime & shale	2230	2250	
Shale & shells	2250	2365	
Shale & lime	2365	2535	
Shale & shells	2535	2705	
Shale & lime	2705	2800	
Broken lime	2800	2930	
Lime & shale	2930	2970	
Lime	2970	2980	
Lime	2980	2015	
Lime	3015	3095	
Lime	3095	3170	
Shale & shells	3170	3245	
Shale	3245	3280	
Lime & shale	3280	3295	
Lime	3295	3375	
Lime & shale	3375	3405	
Lime	3405	3560	
Shale, chert & shells	3560	3576	
Sand & shale	3576	3578	
Lime	3578	3581	
Shale	3581	3582	
Dolomite, Arbuckle	3582	3608	T.D.

LOCATION NOTICE

TULSA, OKLA., Sept. 29, 1948

WELL NO. 8 ON Karl Fischer FARM

WILL BE AS FOLLOWS:

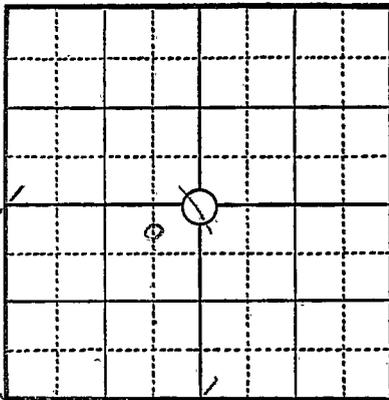

320 FEET FROM NORTH LINE
660 FEET FROM EAST LINE
 FEET FROM SOUTH LINE
 FEET FROM WEST LINE


REMARKS: H. K. McAnahan - Dist. Supt.
H. H. Johnson - Foreman
100% - 100%

SIGNED [Signature]

- COPIES TO
- MR. KOONTZ McDowell
- DISTRICT SUPT.
- ACCOUNTING DEPT.
- SCOUTING DEPT.
- GEOLOGICAL DEPT.
- PIPE LINE DEPT.
- MATERIALS DEPT.
- RENTAL DEPT.
- LEGAL DEPT.
- TAX DEPT.
- ENGINEERING DEPT.
- LEASE INVENTORY
- CLAIM DEPT.
- FILE

Drilling Contractors
 Barnett Drilling Co., Inc.
 Wichita, Kansas

Card
J.H.W.
map

Leo Austin
 J. W. Basore