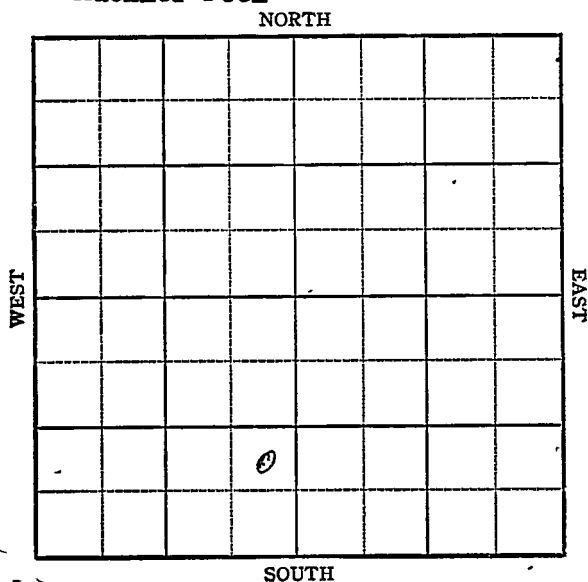


Section 19 Township 21 Range 12-WWell No. #4 Karl FischerCompany Mid-Continent Petroleum
Mueller Pool

HOT FILE

Sec. 19 **KANSAS** Twp. 21 Stafford R. 12W ✓

Well No. #4 Karl Fischer Farm

Mid-Continent Petroleum Company


Mueller Pool

 Ft. from N. Line

990' Ft. from S. Line

330' Ft. from E. Line

 Ft. from W. Line

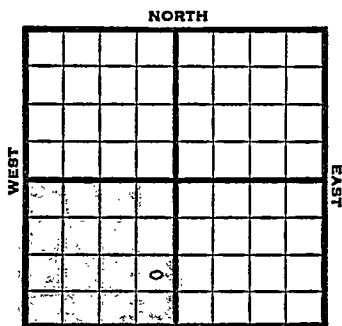

NE SE SW

3750 foot test

1948	Elev. 1872	REPORT
		3750' test.
12/1	Location	
12/7	Digging pits.	
	Moving in tools.	(D R)
12/8	Moving in tools.	"
12/9	Rigging up rotary.	"
12/10	Rigging up rotary.	
12/13	Drilling 885'.	"
12/14	Drilling 1460'.	"
12/15	Drilling 1860'.	"
12/17	Drilling 2425'.	"
12/20	DST. 2895'-2906'.	
	Drilling 3030'.	"
12/22	Drilling 3305'.	"
12/23	Drilling 3425'.	"
12/27	Arbuckle 3580'.	
	Gored 3585'-94'.	
	5 foot recovery, good spotted saturation	
	TD. 3610'.	
	Cemented 5" at 3609'.	(Wire)
12/28	WOC.	(D R)
12/29	Moving in Cardwell unit today.	"
12/30	RU Cardwell unit.	"
12/31	Comp. 12-31-48	
	60 bpd.	"

OVER

1949

1/5

Arb 3584'

5" @ 3609'

42 shots 3589-92

3000 acid

Pump 111 oil Pot.

Gr. 40°

TD 3610'

COMPLETED

Kansas

Mueller Pool

Map No. _____ Sec. 19 Twp. 21 R. 12W

Well No. 4 Karl Fischer

Mid-Continent Petroleum Company

FIRST REPORT

Contractor

NE SE SW


SECTION PLAT

_____ Ft. from N. Line

990 _____ Ft. from S. Line

330 _____ Ft. from E. Line

_____ Ft. from W. Line

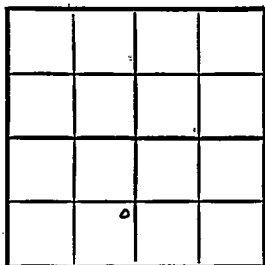

Stafford County

Location X

Rig up

Drilling and Remarks:

RECORD

Cased _____ in., _____ ft.

Sand _____

Gas _____

Oil _____

Total Depth _____

PRODUCTION

1st 24 hrs. Nat. _____

1st 24 hrs. after shot _____

Gas _____ Cu. Ft.

Dry Hole _____

Abandoned _____

Date

DEC 1 1948 19

S. J. LEWIS


Scout

Scout Cards
Land Small Map
Land Wall Map
Tracings
France Map
Pierce Map
Misc.

Map No. K-46 Sec. 19 Twp. 218 R. 12 WWell No. #4 Karl FischerMCPC-100% Company

____ Contractor

SECTION PLAT

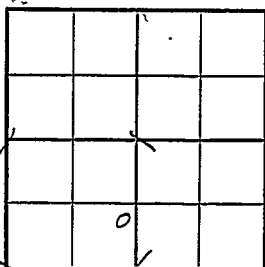

____ Ft. from N. Line

990 Ft. from S. Line330 Ft. from E. Line

____ Ft. from W. Line

Location ✓

Rig up _____

Drilling and Remarks:

RECORD

Cased _____ in., _____ ft.

Sand _____

Gas _____

Oil _____

Total Depth _____

PRODUCTION

1st 24 hrs. Nat. _____

1st 24 hrs. after shot _____

Gas _____ Cu. Ft.

Dry Hole _____

Abandoned _____

Date

Kansas


Mueller Pool

Map No. 46 Sec. 19 Twp. 21 R. 12thWell No. 4 Karl FischerMid-Continent Petroleum Company

COMPLETE

Contractor

NE SE SW

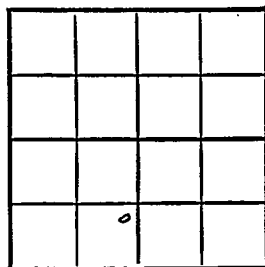E. 1874
SECTION PLAT Ft. from N. Line990 Ft. from S. Line330 Ft. from E. Line Ft. from W. LineStafford CountyLocation Rig up

Drilling and Remarks:

Cr 75087
5" 63609
42 slots 3589-92
8000 acid
Pump 111 oil 105
452-81

RECORD


Cased in., ft.Sand Gas Oil Total Depth 3610

PRODUCTION

1st 24 hrs. Nat. 1st 24 hrs. after shot Gas Cu. Ft.Dry Hole Abandoned

Date

JAN 5 194919S. J. LEWISScout

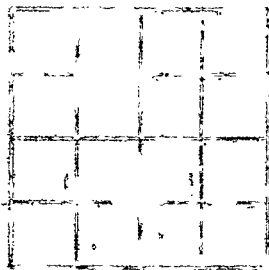

Scout Cards

Land Small Map

Land Wall Map

Tracings

France Map

Pierce Map

Misc.