


Section 19 Township 21 Range 12W

Well No. #3 Hall

Company Stanolind

NORTH

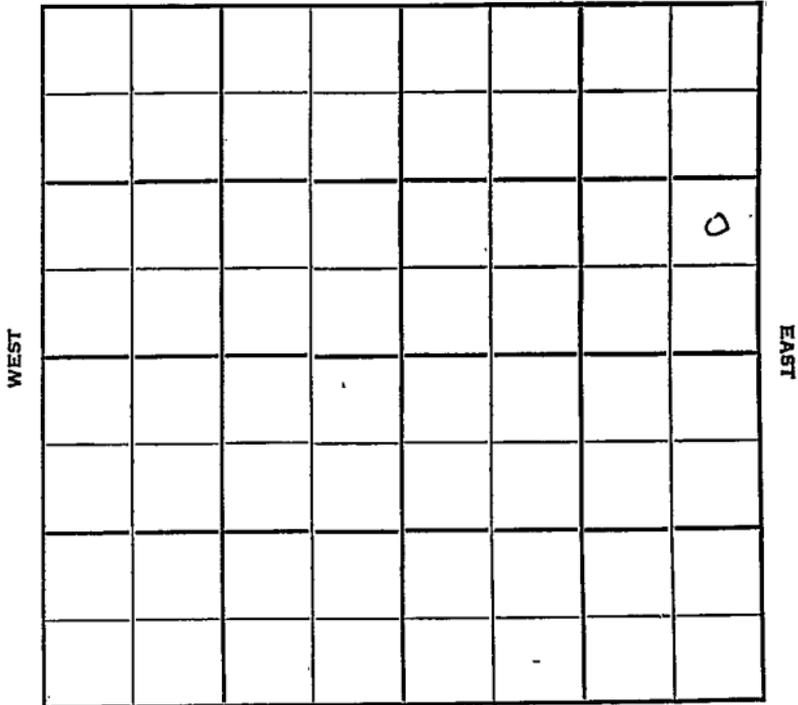

SOUTH

Sec. 19 Twp. 21 R. 12W

Well No. #3 Hall Farm

Stanolind Company

Prime Drlg. - Contr. Contractor


Mueller Pool

 Ft. from N. Line

990' Ft. from S. Line

330' Ft. from E. Line

 Ft. from W. Line

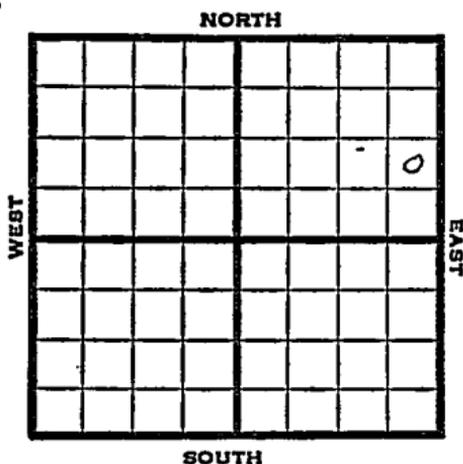

NE SE NE

1951 Elev. 1862' REPORT

5/2 Location

7/25 Spud 6-15-51
 Oil Well TD 3552
 Anhy 677 10" @ 684
 Lans. 3260
 DST 3287-3305 opn 1 hr Rec. 15' mud
 & SSO DST 3328-47 opn 1 hr Rec. 80'
 ocm DST 3376-3446 opn 1 hr Rec. 185'
 ocm Arb. 3541
 DST 3541-52 opn 1 hr Rec. 450' oil
 5" @ 3545 TD 3552
 S/11 boph 500 A Comp depth pot.
 1588 bopd

COMPLETED

County Stafford State Kansas

Sec. 19 (Blk. Twp.) 21 (Sur. Rge.) 12W Map No.

Operator Stanolind

Well No. 3 Farm Hall

Elev. _____ Location NE SE NE

							0

990 Ft. From S Line NE

330 Ft. From E Line Quarter

Ist. Report MAY 2 1951

Completion _____

Remarks _____

Spudding Date _____

Drlg. Data Mueller Pool

Location

J. E. TYRA

County Stafford State Kansas

Sec. 19 (Blk. 21) (Sur. 12W) (Rge.) Map No.

Operator Stanolind

Well No. 3 Farm Hall

Elev. 1862 Location NE SE NE

COMPLETE

990 Ft. From S Line NE

330 Ft. From E Line Quarter

1st. Report

Completion JUL 25 1951

Remarks Mueller Pool

Prime Drlg. - Contr.

Spudding Date 6-15-51

Drlg. Data Oil well TD 3552

Anhy 677 10" @ 684. Lans. 3260

DST 3287-3305 open 1 hr. Rec. 15' mud

& SSO DST 3328-47 open 1 hr. Rec. 80'

ocm DST 3376-3446 open 1 hr. Rec. 185'

ocm Arb. 3541 DST 3541-52 open 1 hr.

Rec. 450' oil 5" @ 3545 TD 3552

S/ 11 boph 500 A Comp. depth. pot. 1588 bopd