


Section 19 Township 21 Range 12W

Well No. #3 Hall

Company Magnolia

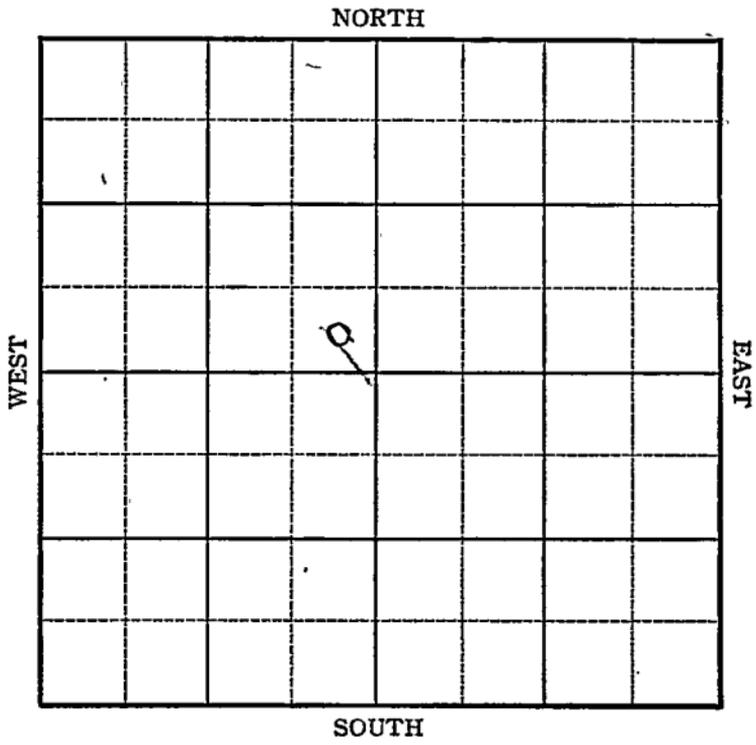

Sec. 19 Twp. 21 R. 12W

Well No. #3, Hall Farm

Magnolia Company

Sittner


Ft. from N. Line

330 Ft. from S. Line

330 Ft. from E. Line

Ft. from W. Line

NORTH

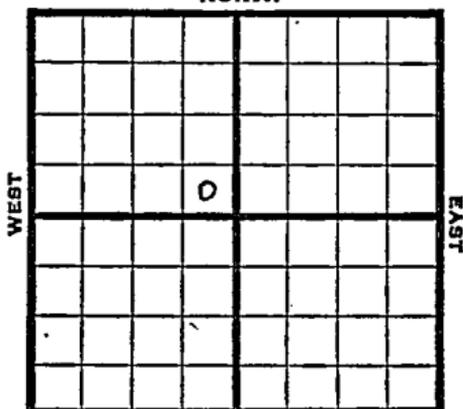

SOUTH

SE NW

Elev. 1860 REPORT

1946

6/12 Location  
 6/18 8" @ 293  
 Drlg 600'  
 6/26 Drlg 3210'  
 7/3 Viola 3496'  
 Simp 3528  
 Arb 3577  
 3579 TD SO  
 5" @ 3578'

7/10 Arb. 3573  
 5" @ 3574  
 500 acid.  
 TD 3578'  
 Pump 442 Pot.  
 Grav. 40.8

COMPLETED



Kansas Pool Name Sittner Pool

KANSAS  
Map No. 46 Sec. 19 Twp. 21 R. 12W

Well No. 3 Hall

Magnolia Company

**COMPLETED**

Contractor

SE NW

E 11860  
SECTION PLAT

\_\_\_\_\_ Ft. from N. Line

330 Ft. from S. Line

330 Ft. from E. Line

\_\_\_\_\_ Ft. from W. Line


Stafford County

Location \_\_\_\_\_

Rig up \_\_\_\_\_

Drilling and Remarks:

*CR 3573*  
*S 3574*  
*500 acid*  
*Pump 442 P.S.*

*H.D. Lewis*

**RECORD**

Cased \_\_\_\_\_ in., \_\_\_\_\_ ft.

Sand \_\_\_\_\_

Gas \_\_\_\_\_

Oil \_\_\_\_\_

Total Depth 357

**PRODUCTION**

1st 24 hrs. Nat. \_\_\_\_\_

1st 24 hrs. after shot \_\_\_\_\_

Gas \_\_\_\_\_ Cu. Ft.

Dry Hole \_\_\_\_\_

Abandoned \_\_\_\_\_

Date

JUL 10 1946 19

S. J. LEWIS Scout