


Stafford  
KANSAS

Section 19 Township 21 Range 12W

Well No. 3 Karl Fischer

Company Mid-Continent Pet

Mueller Pool

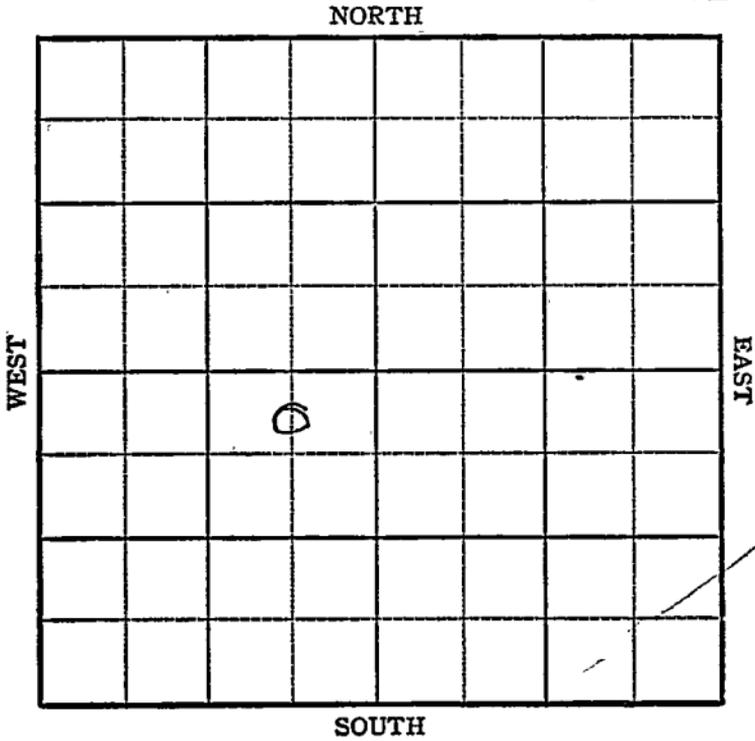

Sec. 19 Twp. 21S R. 12W ✓

Well No. #3 Karl Fischer Farm

Mid-Continent Company


330 Ft. from N. Line --

\_\_\_\_\_ Ft. from S. Line

660 Ft. from E. Line

\_\_\_\_\_ Ft. from W. Line

NE SW

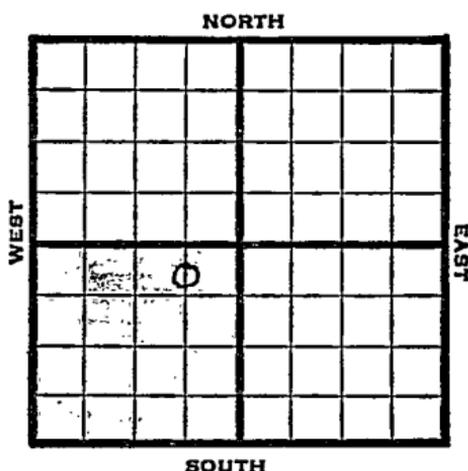

REPORT	
1948	Elev. 1866
	3750' Test
9/29	Location Notice
10/1	Spudded 10-1-48 (D R)
10/4	Set 300' of 8-5/8" csg @ 308' w/ 325 sax. "
10/5	Drilling 1715' "
10/6	Drilling 2005' "
10/7	Drilling 2250' "
10/8	Drilling 2535' "
10/11	Drilling 3135' "
10/12	Drilling 3295' "
10/13	Drilling 3405' "
10/14	Going in to core. "
10/18	MI cable tools. TD 3608' "
10/19	Drilling plugs 3608' Arb. 3578' "
10/20	Perf. 30 shots 3581'-88' Acidized with 500 gal. Rec. oil load & made 2 1/4 bph. on 2 hr test. "
10/21	Expected to acidize with 3000 gal yesterday. No report. "
10/22	Acidized w/3000 gal Wed. Testing TD 3608' "
10/25	Testing. "
10/26	Waiting on tubing & pumping unit. "

OVER

- 1948
- 10/27 Waiting on tubing & pumping unit  
Will report on Wdneds. until com. (DR)
- 11/3 Ran tubing. will set pumping unit & test. "
- 11/3 From Drilling Report  
3000 Acid  
Swb 14 bbls oil / 8 W PH
- 11/10 Connected to pump. Will take State pumping test. "
- 11/10 From Drilling Report  
Run Tubing & Rods. "
- 11/17 Taking state Potential today. "
- 11/18 Comp. 11-17-48  
Pumping 91 bpd. "
- 11/23 TD 3608'  
Arb. 3578'  
5" @ 3608'  
Perf 3500 acid  
Pump 91 Oil / 40% W Pot  
39° Gr.  
Comp

**COMPLETED**

Map No. \_\_\_\_\_ Sec. 19 Twp. 21 R. 12W

Well No. 3 Karl Fischer

Mid-Continent Petroleum Company

**FIRST REPORT**

Contractor

C N L NE SW

SECTION PLAT

330 Ft. from N. Line

\_\_\_\_\_ Ft. from S. Line

660 Ft. from E. Line

\_\_\_\_\_ Ft. from W. Line

	o		

Stafford County

Location X

Rig up \_\_\_\_\_

Drilling and Remarks:

RECORD

Cased \_\_\_\_\_ in., \_\_\_\_\_ ft.

Sand \_\_\_\_\_

Gas \_\_\_\_\_

Oil \_\_\_\_\_

Total Depth \_\_\_\_\_

PRODUCTION

1st 24 hrs. Nat. \_\_\_\_\_

1st 24 hrs. after shot \_\_\_\_\_

Gas \_\_\_\_\_ Cu. Ft.

Dry Hole \_\_\_\_\_

Abandoned \_\_\_\_\_

Date

SEP 29 1948 19

S. J. LEWIS

Scout

1  
10 11

Misc. Small Maps	_____
Cards	<u>  K  </u>
Tracing	<u>  ✓  </u>
France Map	<u>  /  </u>
Scarborough Map	<u>  /  </u>
Pierce Map	<u>  /  </u>
Geological Dept.	<u>  /  </u>
Pierce Plat Book	_____

Map No. 46 Sec. 19 Twp. 21 R. 12W

Well No. 3 Karl Fischer

Mid-Continent Petroleum Company

**COMPLETE**

Contractor

C N L NE SW

*E 11866*  
**SECTION PLAT**

330 Ft. from N. Line

         Ft. from S. Line

660 Ft. from E. Line

         Ft. from W. Line

	o		

Stafford County

Location                                 

Rig up                                 

Drilling and Remarks:

*Cert 3575*  
*5" 03608*  
*Perf*  
*2500 acid*  
*Pump 9/10 oil + 40% wt*  
*Pat 392/41*

**RECORD**

Cased          in.,          ft.

Sand                                 

Gas                                 

Oil                                  

Total Depth 2608

**PRODUCTION**

1st 24 hrs. Nat.                                 

1st 24 hrs. after shot                                 

Gas                                  Cu. Ft.

Dry Hole                                 

Abandoned                                 

Date

NOV 23 1948 19

S. J. LEWIS Scout

Scout Cards  
Land Small Map  
Land Wall Map  
Tracings  
France Map  
Pierce Map  
Misc.

RECORDS


Scout Cards  
Land Small Map  
Land Wall Map  
Tracings  
France Map  
Pierce Map  
Misc.

RECORDS

Scout Cards  
Land Small Map  
Land Wall Map  
Tracings  
France Map  
Pierce Map  
Misc.

Scout Cards	<i>[Signature]</i>
Land Small Map	<i>[Signature]</i>
Land Wall Map	<i>[Signature]</i>
Tracings	<i>[Signature]</i>
France Map	<i>[Signature]</i>
Pierce Map	<i>[Signature]</i>
Misc.	