

DRILLING WELL COMPLETION REPORT

Well No. 4 Farm Name Karl Fischer
Date completed Dec. 31, 1948
Description Lots 3 & 4 & E/2 SW/4 Sec. 19-21S-12W
County Stafford, State Kansas
Initial production 60 bbls. Total depth 3610 feet
Initial volume _____ cu. ft. _____ lbs. rock pressure
Pipe Line Company _____
Gas Company _____
M.C.P.C. Interest 100%
Remarks: _____

A. E. Pierce

W

Mr. Koontz
~~Accounting Dept.~~ McDowell
✓ Scouting Dept.
Geological Dept.
Pipe Line Dept.
Materials Dept.
Rental Dept.
Legal Dept.
Mr. Leo Meyer
Engineering Dept.
Lease Inventory
Mr. Leo Austin
File

Mid-Continent Petroleum Corporation
Karl Fischer Well No. 4

Casing: 8 5/8 297' w/325 sks cement
5 1/2 3605' w/125 sks cement

NE SE SW Sec. 19-21S-12W
Stafford County, Kansas


Commenced: 12-9-48
Completed: 12-31-48
Initial Production: 60 b.p.d.

FORMATION	TOP	BOTTOM
Surface sand & shells	0	75
Shale & shells	75	105
Sand	105	140
Shale & red bed	140	280
Shale & shells	280	306
Red bed & shells	306	615
Red bed & shale	615	885
Red bed	885	960
Shale & shells	960	1200
Shale & lime	1200	1310
Shale & shells	1310	1460
Salt & shale	1460	1520
Lime & shale	1520	1665
Lime	1665	1750
Broken lime & shale	1750	1860
Lime & shale	1860	1995
Lime	1995	2120
Lime & shale	2120	2870
Lime broken	2870	2910
Lime & shale	2910	2965
Lime	2965	3030
Shale & lime	3030	3090
Lime	3090	3132
Shale	3132	3138
Lime	3138	3144
Shale	3144	3152
Lime	3152	3166
Shale	3166	3265
Lime	3265	3272
Lime & shale	3272	3282
Lime	3282	3296
Shale	3296	3299
Lime	3299	3311
Shale & lime	3311	3320
Lime	3320	3334
Lime & shale	3334	3346
Lime	3346	3396
Sandy lime	3396	3422
Lime	3422	3431
Sandy lime	3431	3437
Lime	3437	3455
Shale	3455	3460
Sandy lime	3460	3480
Lime	3480	3494
Shale	3494	3500
Lime	3500	3511
Cherty lime	3511	3541
Shale & sandy dolomite	3541	3585
Dolomite	3585	3610 Total Depth.

LOCATION NOTICE

TULSA, OKLA., December 3, 1948WELL NO. 4 ON Karl Fischer FARM

WILL BE AS FOLLOWS:

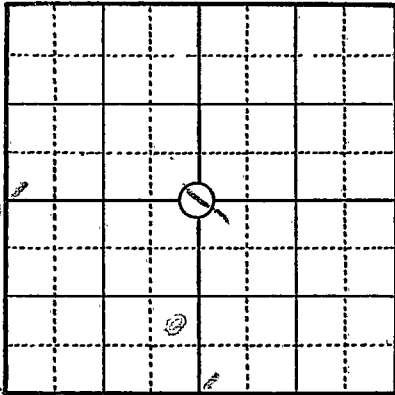

_____ FEET FROM NORTH LINE

330

_____ FEET FROM EAST LINE

990

_____ FEET FROM SOUTH LINE

_____ FEET FROM WEST LINE

Lots 3 & 4 & E/2 SW/4IN _____ SEC. 19 TWP. 21S RANGE 12WStafford COUNTY, STATE OF KansasREMARKS: S. K. McLanahan - Dist. SuperintendentA. E. Johnson - ForemanM. C. P. C. - 100%

SIGNED _____

A. E. Pierce

COPIES TO

MR. ~~KOONTZ~~ McDowell
DISTRICT SUPT.

ACCOUNTING DEPT.

☒ SCOUTING DEPT.

GEOLOGICAL DEPT.

PIPE LINE DEPT.

MATERIALS DEPT.

RENTAL DEPT.

LEGAL DEPT.

TAX DEPT.

ENGINEERING DEPT.

LEASE INVENTORY

CLAIM DEPT.

FILE

Card
J.G.M.
J.G.M.
C