


KANSAS

Stafford County

Section 19 Township 21 Range 12W

Well No. #2 E. B. Hall

Company Magnolia

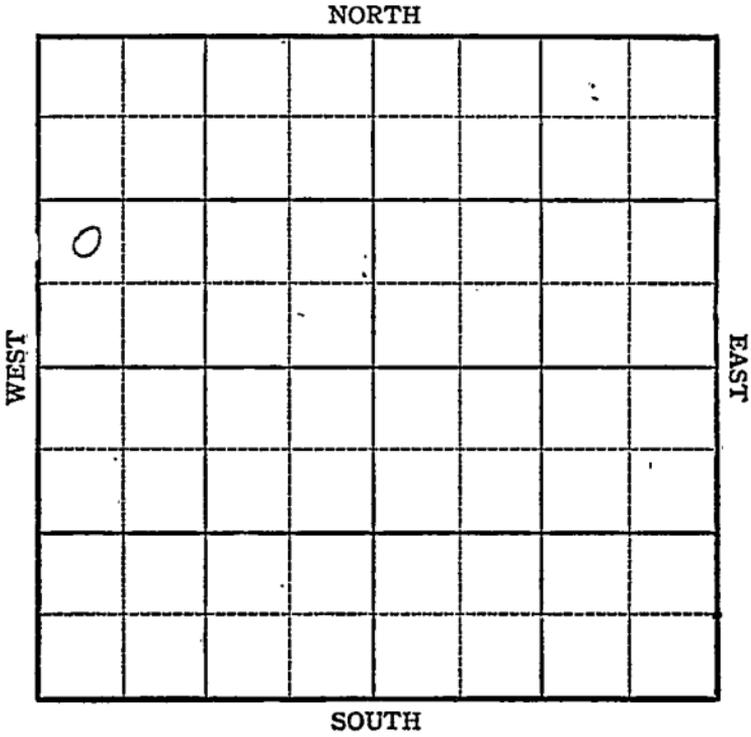

KANSAS

Stafford County

Sec. 19 Twp. 21 R. 12W

Well No. #2 E. B. Hall Farm

Magnolia Company


James

\_\_\_\_\_ Ft. from N. Line

990 Ft. from S. Line

\_\_\_\_\_ Ft. from E. Line

330 Ft. from W. Line

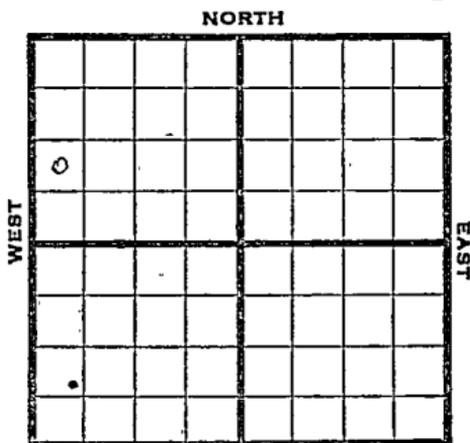

NW SW. NW

*E/V 1868*

SOUTH

1944

R E P O R T

- 10/11 8" - 244 WOC  
Congl. 3534'
- 10-25 Arbuckle 3601 Simpson 3580'  
Cored: 3601-3606 Rec. show of oil, and  
gas from 3603-06  
Set 5" @ 3601  
Rigging up standard tools . (Tel)  
Simpson 3580' SSO 3603-06'
- 10-25 Arbuckle 3601  
Running 20' lower on Arbuckle than Magnolia  
#1 Producer 1/4 mile North.  
Running 58' higher on Arbuckle than Amerada  
drilling in NW/Cor. NE/4 Sec. 25-21-13W.  
Running 57' higher on Arbuckle than Appleman  
Fischer, #1, Center S/2 SW NE 30-21-12W  
(Mr. Beekley)
- 11-1 Total Depth 3612'  
Bail 4 bbls. oil in 24 hours.  
Pump 4 bbls. oil in 24 hours.  
To drill deeper.
- 11-8 Did not drill deeper &  
Acid went back of pipe.  
Plugged Back to 3604.  
Squeeze.
- 11-15 Total Depth 3623'  
Pump 6 oil per day.

OVER

1944

11/22 1000<sub>v</sub> accid pump 5 oil day SW  
Drlg. 3645 6 oil a day & 6  
water

11-29 Total Depth 3690' b  
Bailed 4 bbls. oil plus 12 bbl. water  
per day. (

12/13 Arb. 3601  
5" @ 3601'  
TD 3785'

**ABANDONED**

Pool Name James

Map No. 46 Sec. 19 Twp. 21 R. 12W

Well No. 2 E. B. Hall

Magnolia Company

FIRST REPORT

Contractor

NW SW NW

SECTION PLAT

\_\_\_\_\_ Ft. from N. Line

990 Ft. from S. Line

\_\_\_\_\_ Ft. from E. Line

330 Ft. from W. Line



Stafford County

Location \_\_\_\_\_

Rig up \_\_\_\_\_

Drilling and Remarks:

8" - 244 WOC

*Hot file*

RECORD

Cased \_\_\_\_\_ in., \_\_\_\_\_ ft.

Sand \_\_\_\_\_

Gas \_\_\_\_\_

Oil \_\_\_\_\_

Total Depth \_\_\_\_\_

PRODUCTION

1st 24 hrs. Nat. \_\_\_\_\_

1st 24 hrs. after shot \_\_\_\_\_

Gas \_\_\_\_\_ Cu. Ft.

Dry Hole \_\_\_\_\_

Abandoned \_\_\_\_\_

Date

OCT 11 1944 19

S. J. LEWIS

Scout

Misc. Small Maps	<i>Reid</i>
Cards	<i>Reid</i>
Tracing	<i>Reid</i>
France Map	<input checked="" type="checkbox"/>
Scarborough Map	<i>Reid</i>
Moody Map	<i>Reid</i>
Geological Dept.	
Moody Plat Book	

Pool Name James

Map No. 46 Sec. 19 Twp. 21 R. 12 W

Well No. 2 E. B. Hall 1

Magnolia Company  
**ABANDONED**

Contractor \_\_\_\_\_

NW SW NW

SECTION FLAT

8			

\_\_\_\_\_ Ft. from N. Line

990 Ft. from S. Line

\_\_\_\_\_ Ft. from E. Line

330 Ft. from W. Line

Stafford

Location \_\_\_\_\_

Rig up \_\_\_\_\_

Drilling and Remarks:

*Ce 360/*  
*5" 360/*

RECORD

Cased \_\_\_\_\_ in., \_\_\_\_\_ ft.

Sand \_\_\_\_\_

Gas \_\_\_\_\_

Oil \_\_\_\_\_

Total Depth 3285

PRODUCTION

1st 24 hrs. Nat. \_\_\_\_\_

1st 24 hrs. after shot \_\_\_\_\_

Gas \_\_\_\_\_ Cu. Ft.

Dry Hole \_\_\_\_\_

Abandoned \_\_\_\_\_

Date

DEC 13 1944 19

S. I. LEWIS Scout

Misc. Small Maps	LR
Cards	petty
Tracing	ML
France Map	✓
Scarborough Map	LR
Moody Map	ML
Geological Dept.	
Moody Plat Book	