

Stafford county


FORM 51 5M 6-46 PETROL

KANSAS

Section 19 Township 21 Range 12-W

Well No. #5, McCrary

Company Mid-States

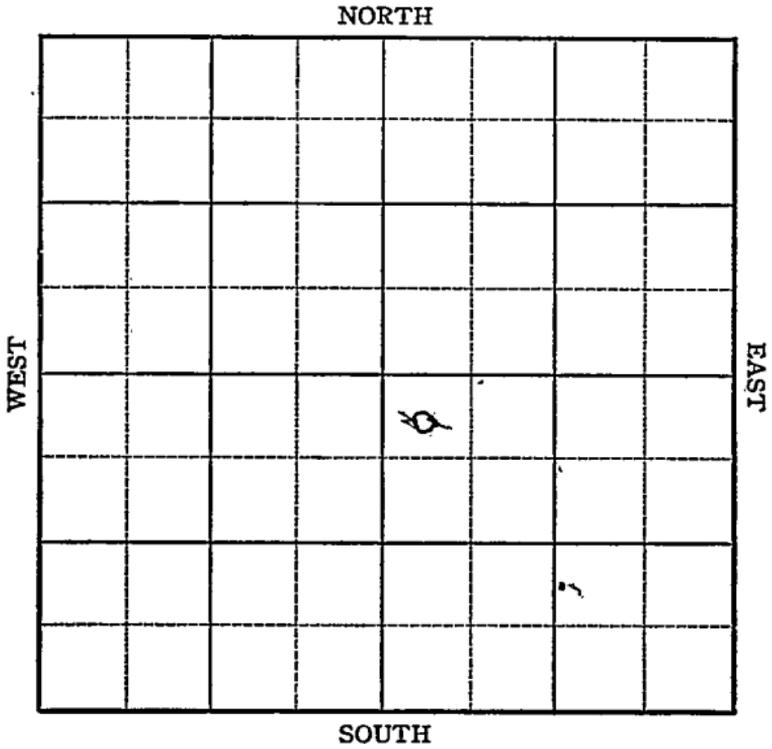

Sec. 19 Twp. 21-S R. 12-W

Well No. #5 McCrary Farm


Mid-States Company

330 Ft. from N. Line

\_\_\_\_\_ Ft. from S. Line

\_\_\_\_\_ Ft. from E. Line

330 Ft. from W. Line

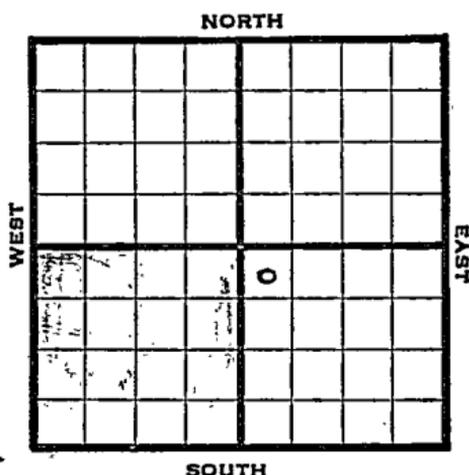

NW SE **OFFSET**

1946 Elev. 1871' REPORT

9/14 Location by Telegram.

9/18 RUR (Ticket)

9/24 10" @ 296'  
Drlg 2280'

10/8 Lans 3264'  
Viola 3500  
Simp 3523'  
Arb 3573  
TD 3575-SO  
5" @ 3573 RUST

10/15 TD 3579-3000 acid  
Pump 20 oil PH 20 hrs

10/22 " " "

11/6 " " "

11/12 " " "

11/20 Arb 3573'  
7" @ 3573'  
TD 3579'  
3000 Acid  
Pump 843 Pot  
41 Grav.

**COMPLETED**



Map No. 76 Sec. 19 Twp. 21 R. 12W

Well No. 5 McCrary

Mid-States Company

**COMPLETED**

Contractor

NW SE

*E. 1871*  
SECTION PLAT

330 Ft. from N. Line

\_\_\_\_\_ Ft. from S. Line

\_\_\_\_\_ Ft. from E. Line

330 Ft. from W. Line

		6	

Stafford County

Location \_\_\_\_\_

Rig up \_\_\_\_\_

Drilling and Remarks:

*Cr 78078*

*7" Cr 3078*

*3000 acid*

*Pump 848 P. 4*

*4108*

**RECORD**

Cased \_\_\_\_\_ in., \_\_\_\_\_ ft.

Sand \_\_\_\_\_

Gas \_\_\_\_\_

Oil \_\_\_\_\_

Total Depth *277*

**PRODUCTION**

1st 24 hrs. Nat. \_\_\_\_\_

1st 24 hrs. after shot \_\_\_\_\_

Gas \_\_\_\_\_ Cu. Ft.

Dry Hole \_\_\_\_\_

Abandoned \_\_\_\_\_

Date

NOV 20 1946 19

S. J. LEWIS

Scout