

DX 78-1

Stafford

**KANSAS**

Section 19 Township 21 Range 12W

Well No. #6 E. B. Hall

Company Magnolia Pet

NORTH

		0					

WEST

EAST

SOUTH

SEC. 19	TWP. 21	R. 12W
------------	------------	-----------

WELL NO. #6 E. B. Hall FARM

COMPANY  
Magnolia Pet.

CONTRACTOR


**Mueller**

\_\_\_\_\_ FT. FROM N. LINE

\_\_\_\_\_ FT. FROM S. LINE

\_\_\_\_\_ FT. FROM E. LINE

\_\_\_\_\_ FT. FROM W. LINE

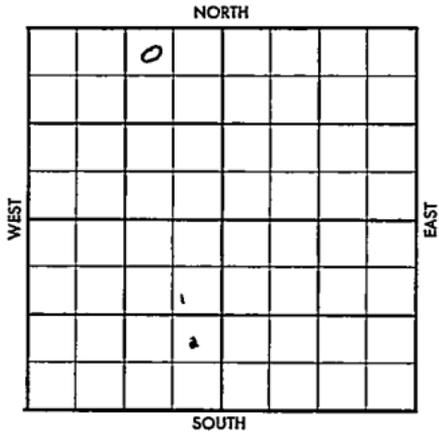

NW NE NW

1956	ELEVATION 1863'	REPORT
------	--------------------	--------

6-27 Location  
7-18 Comm. 6-30-56  
9 5/8" @ 317 w/447  
D & A  
H. 3145'; Tr. 3164'; BL. 3274';  
KC 3291'; C. 3530'; S. 3559'; A. 3605';  
TD 3687'

**ABANDONED**



County Stafford Elev. 1863  
 Sec. 19 Twp. 21 Rge. 12W  
 Company Magnolia Pet.  
 Farm Name B. Hall No. 6

	TOPS	DEPTH	LOG	DATUM
Anh.				
TP				
H		3145		
Tr.		3164		
Dg.				
Bl.		3274		
L.				
K.C.		3291		
B.K.C.				
Ce.				
C.		3530		
M.				
M.				
K.				
Mz.				
Mo.				
V.				
S.		3559		
S.				
A		3605		
R.				
PE.				
G.				
TD		3687		

Loc. in Sec. NW 1/4 NW

Geol. \_\_\_\_\_  
 Contr. \_\_\_\_\_

Pool Mueller

**ABANDONED**  
 JUL 18 1956

Date Comm. JUL 3 '56  
 Location 6-30-56 9578  
317/447 WOC JUL 11 '56 #3292  
JUL 18 '56  
D. & A.

Co.

Lot

No.

Sec.

T.

R.