


KANSAS Stafford

FORM 51 5M PETROL

Section 19 Township 21- Range 12-W

Well No. #3 McCrary

Company Mid-States et al

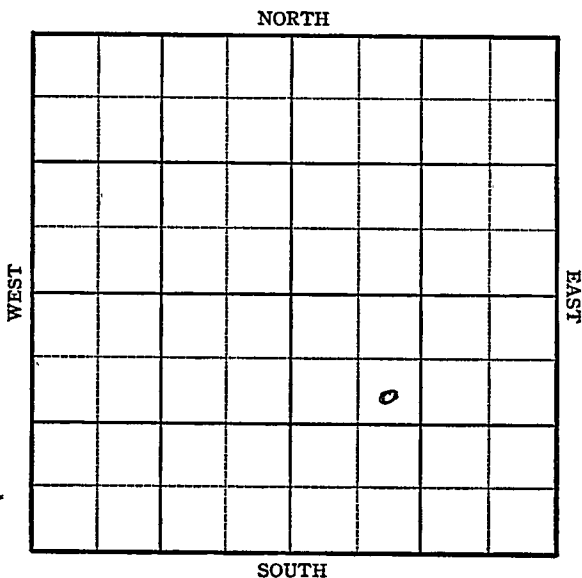

Sec. 19 Twp. 21 R. 12-W

Well No. #3 McCrary Farm


Mid-States Company

990 Ft. from N. Line

_____ Ft. from S. Line

_____ Ft. from E. Line

990 Ft. from W. Line

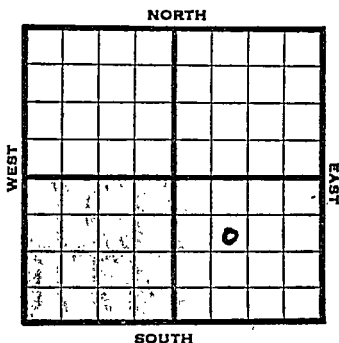

SE NW SE OFFSET

1945 ELV-1867 REPORT

12/28 Location by Telegram.

1946

1/10 R.U.R.

1/17 Surface hole.

1/24 Anhy 685' 10" - 307'

Drlg. 1850'

1/31 Drlg. 3200'

2/7

Lansing 3265'

Viola 3494'

Simpson 3535'

Arbuckle 3588'

Total Depth 3591'

Good show oil

7" set 3588'

Waiting on cement. (Telegram)

2/14

Arbuckle 3588'

7" set 3591'

Total Depth 3594'

Perforated 32 shots 3588 to 91'

1000 Acid f

Flowed 22 bbls oil in 3/4 of an hour.

No water. (Telegram)

2/20

" "

2/28

" "

3/7

" "

3/14

" "

3/21

" "

3/27

" "

4/4

" "

OVER

1946

4/10 Squeeze Perf

TD 3597

2000 acid

4/17 Top Arbuckle 3588'

7" set 3591'

Total Depth 3594'

Perforated 32 shots 3588-91'

1000 acid

Estimated 1 Million Gas

Flowed 22 bbls. oil in 3/4 of an hour.

Showing some water

"Think coming from behind pipe."

Squeezed off perforations

Drilled to Total Depth 3597'

2000 Acid

Pumping Pot. 460' bbls. oil

No water.

(Tel)

4/17 Arb. 3588

7" @ 3591

2500 acid.

TD 3597

Pump 460 oil No. W. Pot.

Grav. 39.0

COMPLETED

KANSAS Kansas Pool Name James


Map No. 11-46 Sec. 19 Twp. 21 R. 12WWell No. 3 McCraryMid-States etal CompanyFIRST REPORT Contractor

SE 17. SE

SECTION PLAT

000 Ft. from N. Line Ft. from S. Line Ft. from E. Line990 Ft. from W. Line

Stafford County

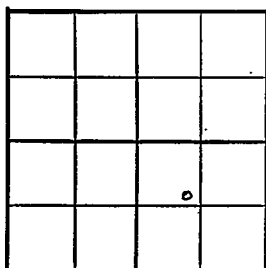Location XRig up

Drilling and Remarks:

RECORD

Cased in, ft.Sand Gas Oil Total Depth

PRODUCTION

1st 24 hrs. Nat. 1st 24 hrs. after shot Gas Cu. Ft.Dry Hole Abandoned

Date

DEC 2 8 1945 19

S. J. LEWIS Scout

Misc. Small Maps	11
Cards	2
Tracing	1
France Map	1
Scarborough Map	1
Pierce Map	1
Geological Dept.	
Pierce Flat Book	

KANSAS

Kansas Pool Name JamesMap No. 46 Sec. 19 Twp. 21 R. 12WWell No. 3 McCraryMid-States etal.

Company

COMPLETED

Contractor

SE NW SE

E 1/8 67
SECTION PLAT990 Ft. from N. Line

Ft. from S. Line

Ft. from E. Line

990 Ft. from W. Line

		0	

Stafford County

Location

Rig up

Drilling and Remarks:

Art 3588
1" @ 3591
2000 acid

Pump 46 oil No. 11
39-82

RECORD

Cased _____ in., _____ ft.

Sand _____

Gas _____

Oil _____

Total Depth 3592

PRODUCTION

1st 24 hrs. Nat. _____

1st 24 hrs. after shot _____

Gas _____ Cu. Ft.

Dry Hole _____

Abandoned _____

Date

APR 17 1946

19

S. J. LEWIS

Scout

Sc. Small Maps

Cards

Tracing

France Map

Scarborough Map

Pierce Map

Geological Dept.

Pierce Plot Book