


Section 19 Township 21 S Range 12 W

Well No. # 7 McCrary "A"

Company Midstates Oil Corp.

NORTH

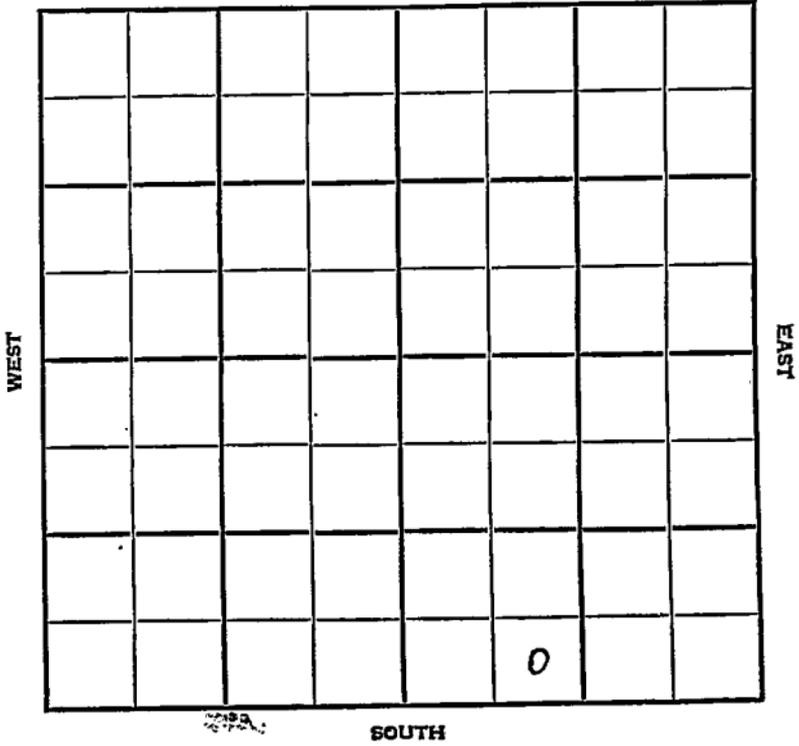

Stafford KANSAS

SEC.	TWP.	R.
19	21 S	12 W

WELL NO. # 7 McCrary "A" FARM

COMPANY: Midstates Oil Corp.

CONTRACTOR: Badger

Mueller


_____ Ft. from N. Line

330 _____ Ft. from S. Line

_____ Ft. from E. Line

990 _____ Ft. from W. Line

SE SW SE

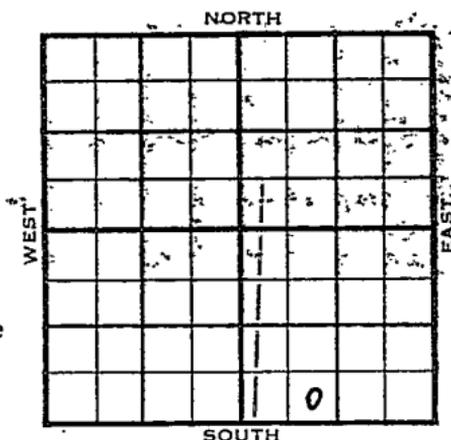

1954	ELEVATION 1866'	REPORT
------	--------------------	--------

12/8 Location

1955
2/16 Spud 12-30-54 - Oil Well
 TD 3576'
 8" @ 320'
 Br. line 3250', Lans. 3266',
 DST 3418-30', opn 1 hr., rec. 90' gcm,
 1230#
 Viola 3486', Simp. 3523', Arb. 3573'
 TD 3576'
 5" @ 3574'
 CO to 3576'
 FU 1600' oil 2 hrs.
 P/9 boph 1% SW
 Comp. 128 bopd

COMPLETED


County Stafford State KANSAS

Sec. 19 (Blk. Twp.) 21S (Sur. Rge.) 12W Map No.

Operator Midstates Oil Corp.

Well No. 7 Farm McCrary "A"

Elev. _____ Location SE SW SE

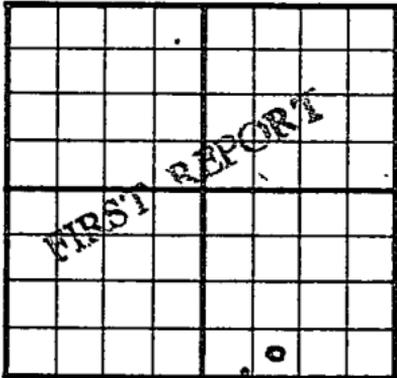

330 Ft. From S Line

990 Ft. From W Line SE Quarter

Ist. Report DEC 8 1954

Completion _____

Remarks _____

Spudding Date _____

Drlg. Data Mueller

Loc.

FABEN GILSTRAP

