


Section 19 Township 21 Range 13W

Well No. #1 Hufford

Company Petroleum, Inc.

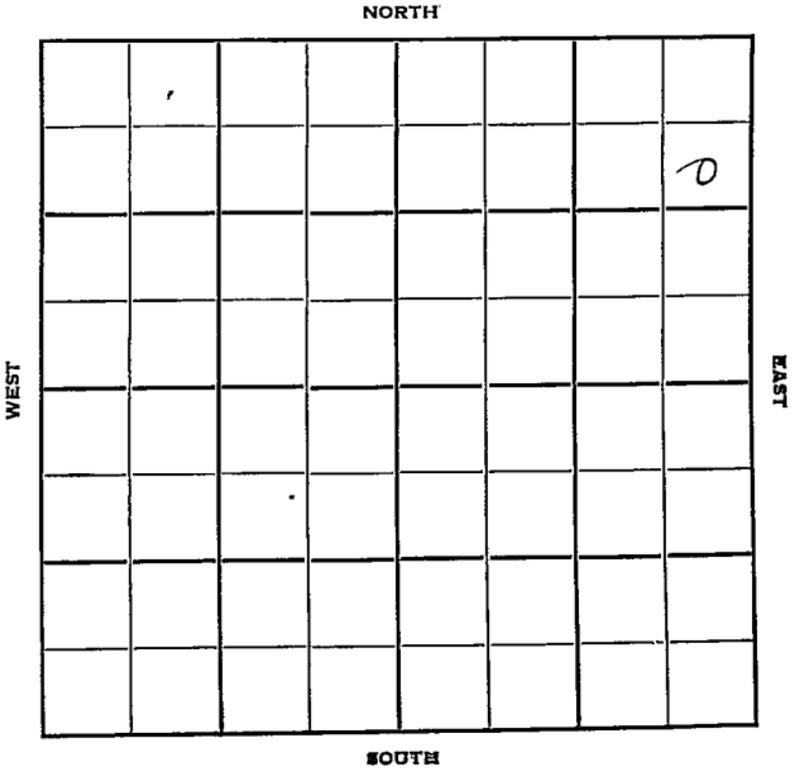

Sec. 19 Twp. \_\_\_\_\_ R. \_\_\_\_\_

Well No. #1 Hufford Farm \_\_\_\_\_

Petroleum Inc. Company \_\_\_\_\_

Pundsack Contractor \_\_\_\_\_


990 Ft. from N. Line

\_\_\_\_\_ Ft. from S. Line

330 Ft. from E. Line

\_\_\_\_\_ Ft. from W. Line

SE NE NE

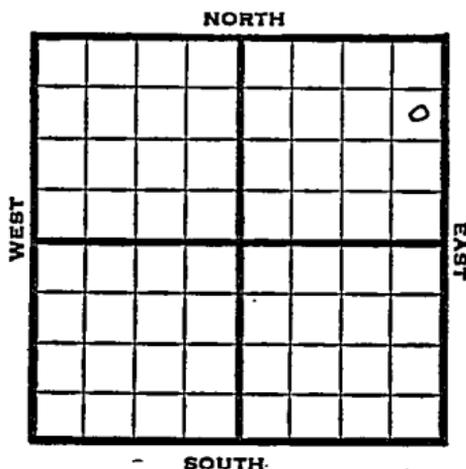

1950 Elev 1911 REPORT

10/18 Spudded and shut down

11/1 Spud 10-20-50

8 5/8" @ 217

Anhy 807 Heeb 3246

Br lime 3368 Lans 3381

Cong 3618 Viola 3640

Simp 3695 Arb 3747

DST 3748-55 opn 1/2 hr rec 5' mud

TD 3790

D&A

**ABANDONED**

County **Stafford** State **Kansas**

Sec. **19** (Blk. Twp.) **21** (Sur. Rge.) **13W** Map No.

Operator **Petroleum Inc.**

Well No. **1** Farm **Hufford**

Elev. **1911** Location **SE NE NE**


**990** Ft. From **N** Line **NE**

**330** Ft. From **E** Line **Quarter**

1st. Report **OCT 18 1950**

Completion

Remarks

Spudding Date

Drlg. Data **Pundsack Pool**

**Spudded & shut down**

J. E. TYRA


County Stafford State Kansas

Sec. 19 (Blk. 21) (Sur. 13W) (Twp.) (Rge.) Map No.

Operator Petroleum Inc.

Well No. 1 Farm Hufford

Elev. 1911 Location SE NE NE

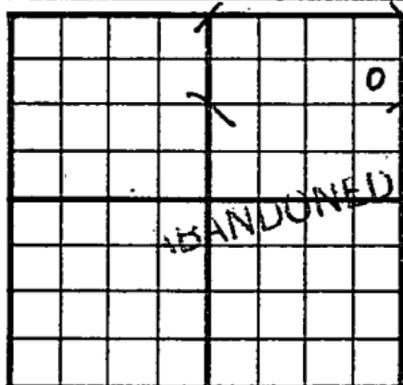

990 Ft. From N Line NE

330 Ft. From E Line Quarter

1st. Report

Completion NOV 1 1950

Remarks Pundsack Pool

Spudding Date 10-20-50

Drlg. Data D & A TD 3790

8 5/8" @ 217 Anhy 807 Heeb. 3246

Br. line 3368 Lans. 3381 Cong. 3618

Viola 3640 Simp. 3695 Arb. 3747

DST 3748-55 open 1/2 hr. Rec. 5' mud

TD 3790 D & A

J. E. TYRA