


Section 19 Township 21 Range 13-W

Well No. #1 Pundsack

Company Harry Gore

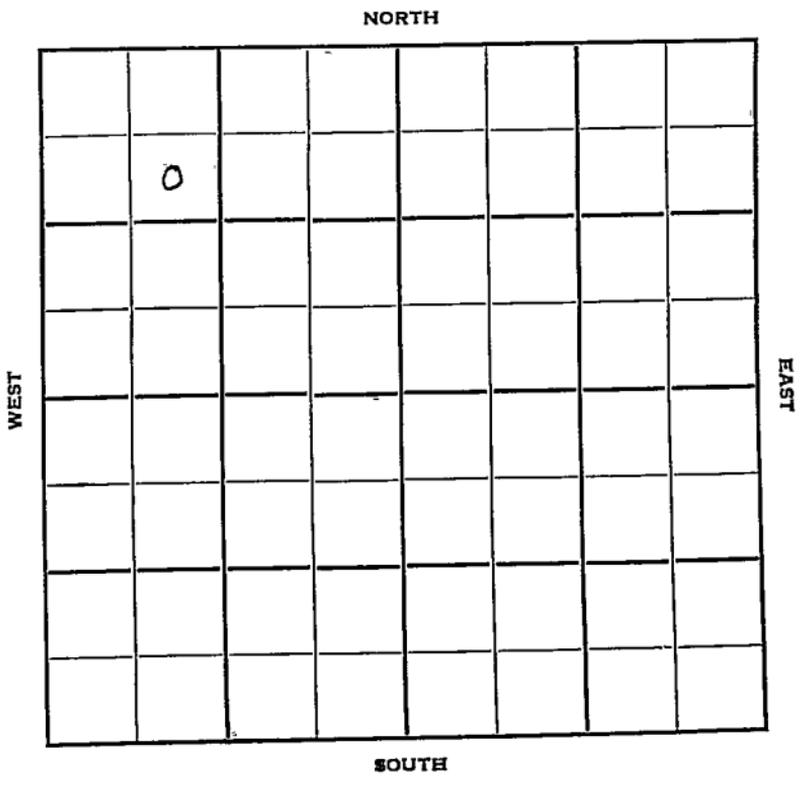

Sec. 19 Twp. 21 R. 13-W

Well No. #1 Pundsack Farm

Harry Gore Company

Veeder Supply Contractor

990 Ft. from N. Line


_____ Ft. from S. Line

_____ Ft. from E. Line

990 Ft. from W. Line

SE NW NW

Stanolind farm

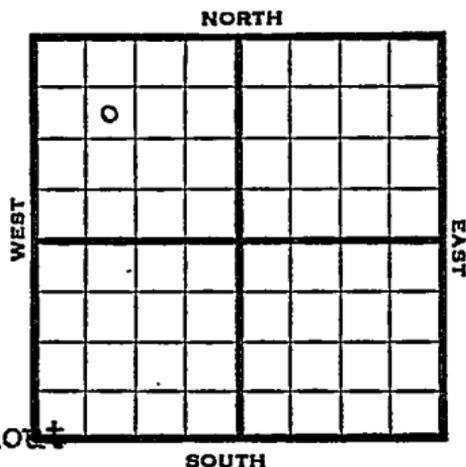

1950

Elev 1921

REPORT

8/2

Spud 7-30-50

8" @ 226

drlg 1295

8/16

8" @ 226

Heeb 3237

Lans 3368

DST 3526-40 opn $\frac{1}{2}$ hr rec 30' salty mud

DST 3549-79 opn $\frac{3}{4}$ hr rec 8' mud

Simp 3649

Arb 3699

SO 3699-3707

DST 3699-3707 opn 45 min rec 12' mud

TD 3740 D&A

ABANDONED

Kansas

Map No. _____ Sec. 19 Twp. 21 R. 13W

Well No. 1 Pundsack

Harry Gore _____ Company

Veeder Supply _____ Contractor

SE NW NW


SECTION PLAT

990 Ft. from N. Line

_____ Ft. from S. Line

_____ Ft. from E. Line

990 Ft. from W. Line

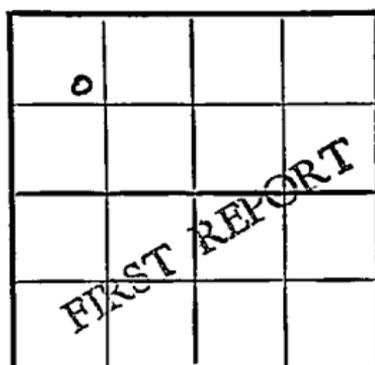

Stafford County

Stanolind farmout

Location _____

Rig up _____

Drilling and Remarks:

Spud 7-30-50

8" @ 226

drig. 1295

RECORD

Cased _____ in., _____ ft.

Sand _____

Gas _____

Oil _____

Total Depth _____

PRODUCTION

1st 24 hrs. Nat. _____

1st 24 hrs. after shot _____

Gas _____ Cu. Ft.

Dry Hole _____

Abandoned _____

Date

AUG 2 1950 19

J. E. TYRA Scout

