


Section 19 Township 21 Range 13W

Well No. #2 Pundsack

Company Stanolind

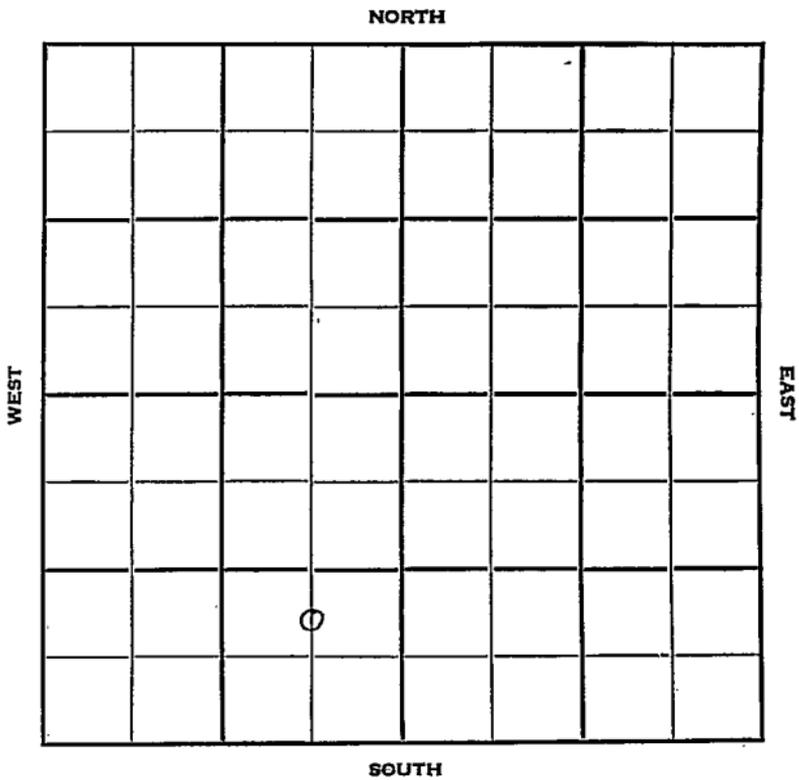

Stafford

KANSAS

Sec. 19 Twp. 21 R. 13W

Well No. #2 Pundsack Farm

Stanolind Company

Iron Drlg. Contractor

Pundsack


\_\_\_\_\_ Ft. from N. Line

990 Ft. from S. Line

660 Ft. from E. Line

\_\_\_\_\_ Ft. from W. Line

C N/2 SE SW

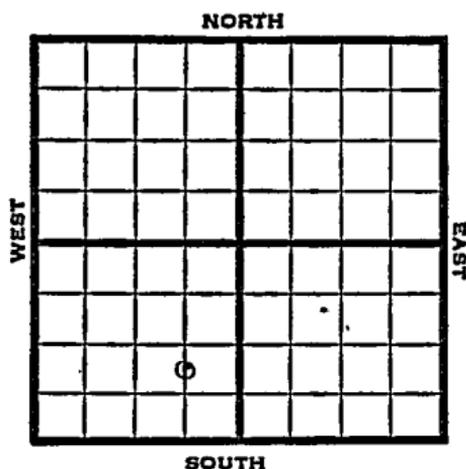

1951

Elev. 1917' REPORT

10/10  
1952  
1/2

Location

Spud 11-6-51 Oil well  
 TD 3792' 8" @ 814' Lans. 3363'  
 DST 3439-60 open 1/2 hr. rec 90' oil  
 DST 3470-3510' open 1/2 hr. rec 1200' oil.  
 DST 3515-55 open 15 min. rec 1620' GCM  
 90' oil, 90' muddy oil, 120' OCM  
 Arb. 3718'  
 DST 3719-21 open 1 hr. rec 7' mud  
 DST 3719-26 open 1/2 hr. rec 40' mud  
 DST 3721-31 open 1 hr. rec 150' MCO  
 710' MCO & water, 240' sul. water  
 DST 3782-92 open 20 min, rec 15' sul  
 water.  
 TD 3792' 5" @ 3791' 24/3718-22  
 B/6 BOPH 500 A S/20 BOPH  
 S/9 BOPH  
 Comp. 424 BOPD

**COMPLETED**



