


Section 19 Township 21 Range 13W

Well No. #2 Pundsack

Company Stanolind

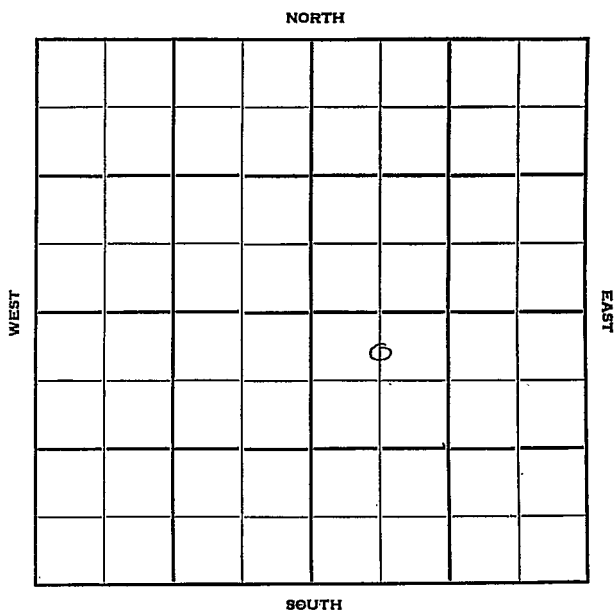

Stafford

KANSAS

Sec. 19 Twp. 2I R. 13 W ✓

Well No. # 2 Pundsack Farm

Stanolind Company

Pundsack Contractor


330 Ft. from N. Line

_____ Ft. from S. Line

_____ Ft. from E. Line

660
990 Ft. from W. Line

C N/2 NW SE

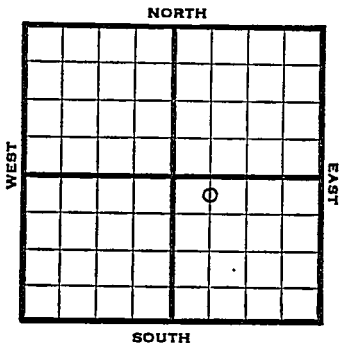

1951

Elev. 1915' REPORT

10/17

Location

11/7

Spud 10-15-51

D&A TL 3875

8" @ 819

Lans. 3389

DST 3508-42 Rec. 25' mud

Arb. 3767 DST 3616-57 opn 45 min.

Rec. 120' mud DST 3679-82 opn 1 hr

Rec. 15' ocm TD 3875

D&A

ABANDONED

County Stafford State Kansas

Sec. 19 (Blk. Twp.) 21 (Sur. Rge.) 13W Map No.

Operator Stanolind

Well No. 2 Farm Pundsack

Elev. 1915 Location C N L NW SE

330 Ft. From N Line SE

660 Ft. From W Line Quarter

Ist. Report

Completion NOV 7 1951

Remarks

Moran Drlg. - Contr.

Spudding Date 10-15-51

Drlg. Data D & A TD 3875

8" @ 819 Lans. 3389 DST 3508-42

Rec. 25' mud Arb. 3767 DST 3616-57

open 45 min. Rec. 120' mud DST 3679-82

open 7 hr. Rec. 15' ocm TD 3875

D & A

J. E. TYRA