


Section 19 Township 21 Range 13W

Well No. #2 Pindsack

Company Petroleum Inc.

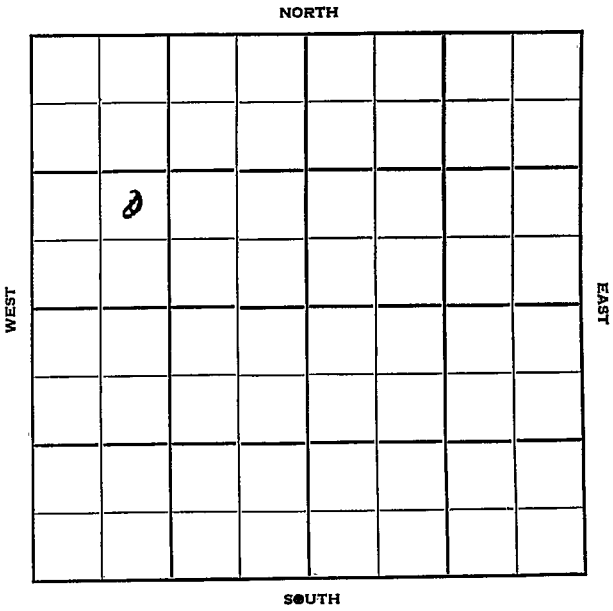

Sec. 19 Twp. R.

Well No. # 2 Pundsack Farm

Petroleum Inc. Company

Pundsack Pool Contractor


Ft. from N. Line

990 Ft. from S. Line

Ft. from E. Line

990 Ft. from W. Line

NE SW NW

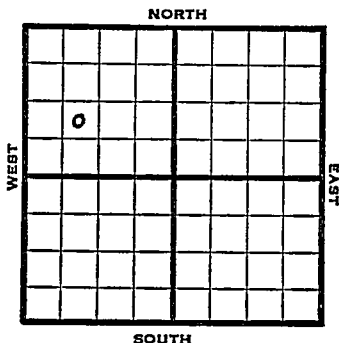

1952

Elev. 1919' REPORT

1/2

Spud 12-28-51
8" @ 333'
Drlg. 1450'

1/16

Spud 12-28-51
D & A TD 3711' 8" @ 333
Heeb 3234' Br. line 3355'
Lans. 3366'
DST 3503-35 open 45 min. rec 10' VSO
CM
DST 3542-75 open 45 min. rec 4' mud,
Viola 3607' Simp. 3643'
DST 3609-45 open 1/2 hr. rec 10' OCM
Simp. 3664-68'
DST 3626-75 open 1 hr. rec 70' mud
Arb. 3698' TD 3711'
D & A

ABANDONED

