


Section 19 Township 21 Range 13WWell No. #1 Pundsack "A"Company Stanolind

NORTH

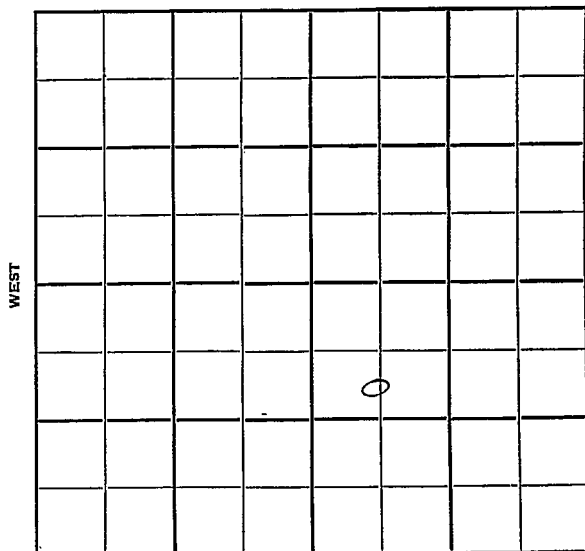

SOUTH

Stafford

KANSAS

Sec. 19 Twp. 21 R. 13W

Well No. #1 Pundsack "A" Farm

Stanolind Company

Contractor

Pundsack Pool


990' Ft. from N. Line

Ft. from S. Line

Ft. from E. Line

660' Ft. from W. Line

C S L NW SE

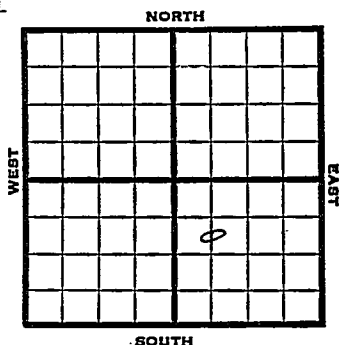

1951

Elev. 1914' REPORT

5/23
7/18

Location

Spud 6-10-51

Oil Well TD 3720

8" @ 814

Lans. 3358

DST 3421-47 opn 1 hr Rec. 480' oil

DST 3472-94 opn 1 hr Rec. 2700' oil

DST 3518-29 Rec. 20' mud 2½ mcf
60' ocm

DST 3539-96 opn 1 hr Rec. 15' mud

Arb. 3712-13 5" @ 3712 TD 3713


S/6½ boph 500 A S/11½ boph S/12½

boph DD 3717 S/16 boph DD 3720

wtr PB 3717 Comp. 356 bopd 7% wtr

COMPLETED

J. E. ...

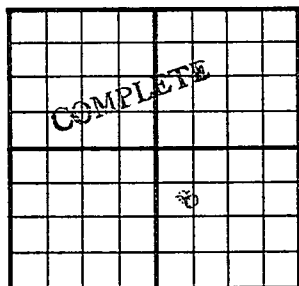County Stafford State KansasSec. 19 (^{Blk.}Twp.) 21 (^{Sur.}Rge.) 13W Map No.Operator StanolindWell No. 1 Farm PundsackElev. 1914 Location C S L NW SE990 Ft. From N Line SE660 Ft. From W Line Quarter

1st. Report

Completion JUL 18 1951Remarks Pundsack PoolSpudding Date 6-10-51Drilg. Data Oil well TD 37208" @ 814 Lans. 3358 DST 3421-47open 1 hr. Rec. 480' oil DST 3472-94open 1 hr. Rec. 2700' oil DST 3518-29Rec. 20' mud 2 $\frac{1}{2}$ mcfg 60' ocmDST 3539-96 open 1 hr. Rec. 15' mudArb. 3712-13 5" @ 3712 TD 3713S/ 6 $\frac{1}{2}$ boph 500 A S/ 11 $\frac{1}{2}$ boph S/ 12 $\frac{1}{2}$ boph DD 3717 S/ 16 boph DD 3720water PB 3717 Comp. 356 bopd 7% water

J. E. TYRA